


STATE OF KANSAS  
STATE CORPORATION COMMISSION

WELL PLUGGING RECORD

Give All Information Completely  
Make Required Affidavit  
Mail or Deliver Report to:  
Conservation Division  
State Corporation Commission  
211 No. Broadway  
Wichita, Kansas

NORTH

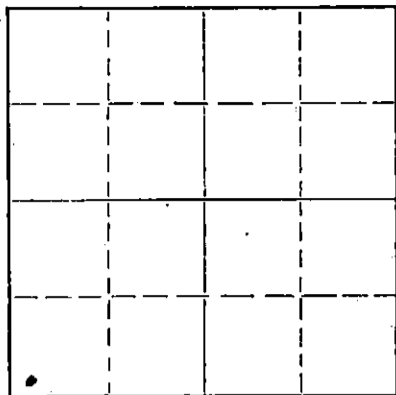

Locate well correctly on above  
Section Plat

Kiowa County. Sec. 29 Twp. 29S Rge. 18(w)  
Location as "NE/CNWxSWx" or footage from lines 100' N. of Center SW SW SW  
Lease Owner Gulf Oil Corporation  
Lease Name Nichols Waste Water Sys.-H. W. Zentz Well No. 1-SWD  
Office Address Box 661, Tulsa, Oklahoma  
Character of Well (completed as Oil, Gas or Dry Hole) Gas-Converted to SWD 1-9-57  
Date well completed 10-11 19 55  
Application for plugging filed 12-6 19 57  
Application for plugging approved 12-9 19 57  
Plugging commenced 12-12 19 57  
Plugging completed 12-17 19 57  
Reason for abandonment of well or producing formation Well was not successful as  
SWD well.

If a producing well is abandoned, date of last production - - 19 -  
Was permission obtained from the Conservation Division or its agents before plugging was com-  
menced? Yes

Name of Conservation Agent who supervised plugging of this well M. A. Rives  
Producing formation \_\_\_\_\_ Depth to top \_\_\_\_\_ Bottom \_\_\_\_\_ Total Depth of Well 5079 Feet  
Show depth and thickness of all water, oil and gas formations.

OIL, GAS OR WATER RECORDS

CASING RECORD

FORMATION	CONTENT	FROM	TO	SIZE	PUT IN	PULLED OUT
				13-3/8"	186'	0
				8-5/8"	1098'	0
				5-1/2"	4973'	3385'

Describe in detail the manner in which the well was plugged, indicating where the mud fluid was placed and the method or methods used in introducing it into the hole. If cement or other plugs were used, state the character of same and depth placed, from \_\_\_\_\_ feet to \_\_\_\_\_ feet for each plug set.

Filled hole with sand to 3725' & spotted 5 sx. cement. Filled with mud to 300', set rock bridge, & spotted 20 sx. cement. Mudded to 35', set rock bridge, & capped with 10 sx. cement, filling hole into cellar.

NOTE: W. C. Bunch - Special Petty Cash, Check No. 1977, dated 12-26-57, in the amount of \$50.79, is attached as payment of plugging assessment.

STATE CORPORATION COMMISSION  
DEC 31 1957  
12-31-57  
CONSERVATION DIVISION  
Wichita, Kansas

(If additional description is necessary, use BACK of this sheet)  
Name of Plugging Contractor C. E. Shull Casing Pulling Company  
Address Box 558, Great Bend, Kansas

STATE OF Kansas, COUNTY OF Sedgwick, ss.  
Thomas A. Trax (employee of owner) of the above-described well, being first duly sworn on oath, says: That I have knowledge of the facts, statements, and matters herein contained and the log of the above-described well as filed and that the same are true and correct. So help me God.

(Signature) [Signature]  
Box 2233, Wichita, Kansas  
(Address)

SUBSCRIBED AND SWORN to before me this 26th day of December, 19 57  
My commission expires 6-3-61

[Signature] Notary Public.  
C. C. LEWIS, NOTARY PUBLIC

PLUGGING  
FILE SEC 29 T 29 R 18w  
BOOK PAGE 66 LINE 29

