


STATE OF KANSAS
STATE CORPORATION COMMISSION
Give All Information Completely
Make Required Affidavit
Mail or Deliver Report to:
Conservation Division
State Corporation Commission
800 Bitting Building
Wichita, Kansas

WELL PLUGGING RECORD

FORMATION PLUGGING RECORD

Strike out upper line when reporting plugging of formations.

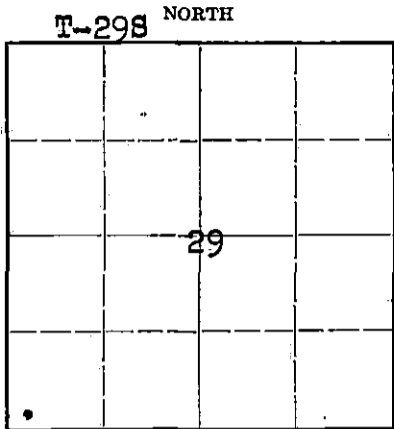

Locate well correctly on above Section Plat.

Location as "NE $\frac{1}{4}$ NW $\frac{1}{4}$ SW $\frac{1}{4}$ " or footage from lines. SW $\frac{1}{2}$, SW $\frac{1}{4}$, SW $\frac{1}{2}$

County. Sec. 29 Twp. 29S Rge. (E) 18 (W)
Lease Owner. Stanolind Oil and Gas Company
Lease Name. Dora Zentz Well No. 1

Office Address. Box 591, Tulsa 2, Oklahoma

Character of Well (completed as Oil, Gas or Dry Hole) Dry Hole

Date well completed May 25 19 45

Application for plugging filed May 29 19 45

Application for plugging approved By Phone 5-29, By Letter 6-4 19 45

Plugging commenced May 30 19 45

Plugging completed May 30 19 45

Reason for abandonment of well or producing formation. No Commercial Show of Oil or Gas encountered

If a producing well is abandoned, date of last production. None 19

Was permission obtained from the Conservation Division or its agents before plugging was commenced? Yes

Name of Conservation Agent who supervised plugging of this well. Mr. H. W. Kerr
Producing formation. None Depth to top. Bottom. Total Depth of Well. 5440 Feet


Show depth and thickness of all water, oil and gas formations.
OIL, GAS OR WATER RECORDS CASING RECORD

Formation	Content	From	To	Size	Put In	Pulled Out
Lansing	Water	4280	4400	13-3/8"	186	None
Mississippian	Water	4897	5000	8-5/8"	1098	None
Misner	Water	5084	5086			
Simpson	Water	5342	5383			
Arbuckle	Water	5383	5440			

Describe in detail the manner in which the well was plugged, indicating where the mud fluid was placed and the method or methods used in introducing it into the hold. If cement or other plugs were used, state the character of same and depth placed, from feet to feet for each plug set.

Filled with mud from 5440' to 500', ran 20 sacks cement, then filled with mud to 30' and capped with 10 sacks cement to bottom of cellar.

FILE 29 29 1945
BOOK 14 10

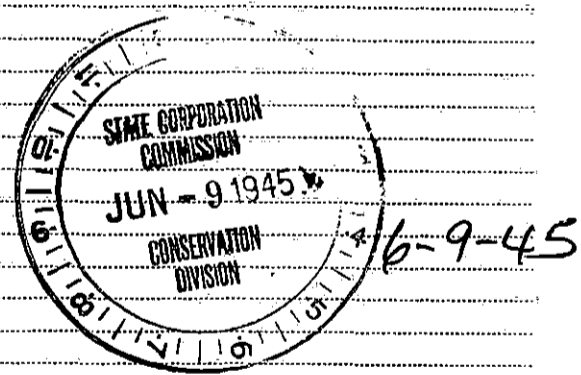

(If additional description is necessary, use BACK of this sheet)

Correspondence regarding this well should be addressed to Mr. C. B. Snyder
Address. Box 518, Zenith, Kansas

STATE OF Kansas, COUNTY OF Stafford, ss.
C. B. Snyder (employee of owner) or (owner or operator) of the above-described well,

being first duly sworn on oath, says: That I have knowledge of the facts, statements, and matters herein contained and the log of the above-described well as filed and that the same are true and correct. So help me God.

(Signature) C. B. Snyder Field Supt.

Box 518, Zenith, Kansas (Address)

Subscribed and Sworn to before me this 7 day of June 19 45
W. C. Robinson Notary Public.

FORMATION RECORD

Give detailed description and thickness of all formations drilled through and contents of sand, whether dry, water, oil or gas.

Formation	Top	Bottom	Formation	Top	Bottom
Collar	0	11			
Surface Clay	11	60			
Sand	60	157			
Blue Shale	157	166			
Shale and Shells	166	303			
Sand	303	341			
Red Rock & Shells	341	490			
Shale and Shells	490	1033			
Anhydrite	1033	1110			
Shale and Salt	1110	1413			
Shale and Shells	1413	2230			
Broken Linc	2230	2400			
Sandy Linc	2400	2700			
Linc and Shale	2700	2770			
Linc	2770	4140			
Shale	4140	4280			
Coal, Top Layer	4280				
Linc	4280	4453			
Linc and Chert	4453	4966			
Coal, Top Concretion	4966				
Linc, Shale & Chert	4966	4990			
Linc & Chert	4990	4990			
Linc	4990	5015			
Chert	5015	5004			
Coal, Top Washer	5004				
Linc	5004	5007			
Sand	5007	5007			
Coal, Top Viola	5007				
Chert	5007	5100			
Linc and Chert	5100	5100			
Shale and Chert	5100	5143			
Linc	5143	5172			
Linc and Chert	5172	5280			
Linc	5280	5342			
Coal, Top Simpson	5342				
Shale	5342	5369			
Dolomite & Shale	5369	5383			
Coal, Top Archickie	5383				
Dolomite	5383	5387			
Linc	5387	5440			
Total Depth:					
By Rotary Pipe		5440			
By Reamer		5440			
Completed on Dry Hole	May 28, 1943				
Plugged and Abandoned	May 30, 1943				