


STATE OF KANSAS
STATE CORPORATION COMMISSION

Form CP-4

Give All Information Completely
Make Required Affidavit
Mail or Deliver Report to:
Conservation Division
State Corporation Commission
P. O. Box 17027
Wichita, Kansas 67217
NORTH

WELL PLUGGING RECORD

Kiowa County. Sec. 29 Twp. 29 Rge. 18 (E) W (W)
Location as "NE/CNWxSWx" or footage from lines C SE SE
Lease Owner Misco Supply Co.
Lease Name Zentz (tract 8) Well No. # 4
Office Address 257 N. Bdwy. ; Wichita, Kansas 67202
Character of Well (completed as Oil, Gas or Dry Hole) _____
Date well completed _____ 19__
Application for plugging filed March 19 72
Application for plugging approved March 19 72
Plugging commenced April 21 19 72
Plugging completed April 24 19 72
Reason for abandonment of well or producing formation _____

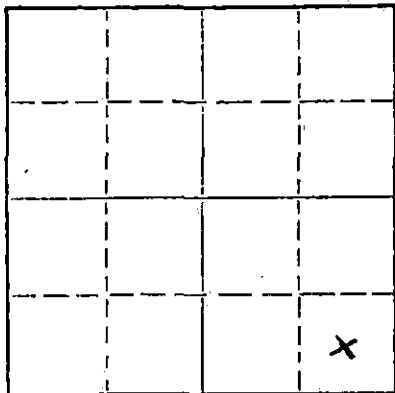

Locate well correctly on above
Section Plat

If a producing well is abandoned, date of last production _____ 19__
Was permission obtained from the Conservation Division or its agents before plugging was commenced? Yes

Name of Conservation Agent who supervised plugging of this well Russell Biberstein
Producing formation _____ Depth to top _____ Bottom _____ Total Depth of Well _____ Feet
Show depth and thickness of all water, oil and gas formations.

OIL, GAS OR WATER RECORDS

CASING RECORD

FORMATION	CONTENT	FROM	TO	SIZE	PUT IN	PULLED OUT
				8 5/8"	411	None
				4 1/2"	5088	3165

Describe in detail the manner in which the well was plugged, indicating where the mud fluid was placed and the method or methods used in introducing it into the hole. If cement or other plugs were used, state the character of same and depth placed, from _____ feet to _____ feet for each plug set.

April 21, 1972 Plugged off bottom. Dumped sand to 4400'. Mixed and dumped 5 sx of cement.

April 24, 1972 Plugged off top. Set 10' rock bridge at 220'. Filled 8 5/8" surface casing from 220' to base of cellar with 3000 lb. P.S.I. ready-mix concrete.

RECEIVED
STATE CORPORATION COMMISSION

MAY 26 1972 5-26-72

CONSERVATION DIVISION
Wichita, Kansas

(If additional description is necessary, use BACK of this sheet)

Name of Plugging Contractor RISS CASING PULLING, INC.
Address P. O. Box 1082 ; Great Bend, Kansas 67530

STATE OF Kansas, COUNTY OF SeDgwick, ss.
Thomas R. Sproul (employee of owner) or (owner or operator) of the above-described well, being first duly sworn on oath, says: That I have knowledge of the facts, statements, and matters herein contained and the log of the above-described well as filed and that the same are true and correct. So help me God.

(Signature) Thomas R. Sproul
257 N. Broadway Wichita, Kans. (Address)

Subscribed and sworn to before me this 25th day of May, 19 72



Celeste Kinzie
Notary Public.


COPY
 15-097-10087-0000

Company- GULF OIL CORP.
 Farm- H. W. Zentz No. 4

SEC. 29 T. 29 R. 18W
 C SE SE

Total Depth: 5074'
 Comm. 8-5-57 Comp. 8-21-57
 Shot or Treated.
 Contractor. Falcon Seaboard Drig.
 Issued. 6-21-58

County Kiowa
 KANSAS

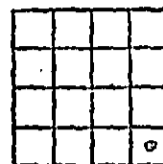

Elevation. 2212' DE

Production. Dry

CASINO:

8 5/8" 412' cem w/300 sx.
 5 1/2" 5074' cem w/125 sx.

Figures indicate Bottom of Formations.

clay	100
clay & red bed	413
red bed & shale	2013
shale & lime	2593
lime	2863
lime & shale	3537
lime	3713
lime & shale	3820
lime	4079
lime & shale	4325
lime	4781
lime & shale	4834
lime	4908
lime & chert	5016
lime	5074
Total Depth	

TOPS:

Brown Lime (scout)	4300
Lansing-Kansas City	4328
Marmaton	4754
Mississippian Chert	4941
Mississippian Lime	5048

Perf. 4961' w/8 shots, acidized w/200 gal. 15%.
 Squeezed perf. 4961' w/50 sx. Pozmix #1,
 Perf. 4966-75' w/4 holes per foot. Acidized
 w/200 gal. MA. Treated w/710 gal. oil,
 250# sand, & 71# Adomite,
 Treated w/5000 gal. Visofrac, 500# Adomite,
 & 5000# sand.

RECEIVED
 STATE CORPORATION COMMISSION
 MAR 9 1972
 CONSERVATION DIVISION
 Wichita, Kansas