


STATE OF KANSAS
STATE CORPORATION COMMISSION

Form CP-4

WELL PLUGGING RECORD

Give All Information Completely
Make Required Affidavit
Mail or Deliver Report to:
Conservation Division
State Corporation Commission
212 No. Market
Wichita, Kansas 67202

NORTH

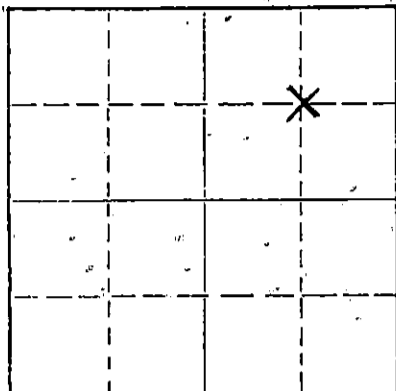

Locate well correctly on above
Section Plat

Kiowa County. Sec. 29 Twp. 29 Rge. 18 (E) W (W)
Location as "NE/CNWxSWx" or footage from lines C NE NE
Lease Owner Misco Supply Co.
Lease Name Zentz Well No. # 3
Office Address 257 North Broadway ; Wichita, Kansas 67202
Character of Well (completed as Oil, Gas or Dry Hole) _____
Date well completed _____ 19____
Application for plugging filed September 19 71
Application for plugging approved September 19 71
Plugging commenced October 13 19 71
Plugging completed: November 6 19 71
Reason for abandonment of well or producing formation _____

If a producing well is abandoned, date of last production _____ 19____
Was permission obtained from the Conservation Division or its agents before plugging was commenced? Yes

Name of Conservation Agent who supervised plugging of this well Russell Biberstein
Producing formation _____ Depth to top _____ Bottom _____ Total Depth of Well _____ Feet
Show depth and thickness of all water, oil and gas formations.

OIL, GAS OR WATER RECORDS

CASING RECORD

FORMATION	CONTENT	FROM	TO	SIZE	PUT IN	PULLED OUT
				8 5/8"	412	None
				5 1/2"	5088	2210

Describe in detail the manner in which the well was plugged, indicating where the mud fluid was placed and the method or methods used in introducing it into the hole. If cement or other plugs were used, state the character of same and depth placed, from _____ feet to _____ feet for each plug set.

October 13, 1971 Plugged off bottom. Dumped sand to 4900'. Mixed and dumped 5 sx of cement to 4860'.
November 6, 1971 Plugged off top. Set 20' rock bridge at 260'. Filled 8 5/8" surface casing with 3000 lb. P.S.I. ready-mix concrete.

RECEIVED
STATE CORPORATION COMMISSION
NOV 22 1971
CONSERVATION DIVISION
Wichita, Kansas

11-22-71

(If additional description is necessary, use BACK of this sheet)

Name of Plugging Contractor RUSS CASING PULLING, INC.
Address P.O. Box 1082 Great Bend, Kansas 67530

STATE OF Kansas, COUNTY OF Sedgwick, ss.
Thomas R. Sproul (employee of owner) or (owner or operator) of the above-described well, being first duly sworn on oath, says: That I have knowledge of the facts, statements, and matters herein contained and the log of the above-described well as filed and that the same are true and correct. So help me God.

(Signature) Thomas R Sproul
257 N. Broadway, Wichita, Kansas

Subscribed and sworn to before me this 19th day of November, 1971
My commission expires March 22, 1972
Celeste Kinzie
Notary Public.



WELL LOG BUREAU—KANSAS GEOLOGICAL SOCIETY
508 East Murdock, Wichita, Kansas


COPY

Company- GULF OIL CORP.
Farm- H. W. Zentz No. 3

SEC. 29 T. 29 R. 18W
C NE NE

Total Depth. 5100'
Comm. 6-2-57 Comp. 6-18-57
Shot or Treated.
Contractor. Falcon-Seaboard Drlg.
Issued. 8-1-58

County Kiowa KANSAS

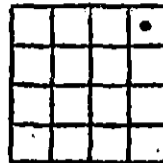

Elevation. 2236' KB

Production. 22 BOPD

Figures Indicate Bottom of Formations.

sand & clay	244
clay & red bed	413
red bed, shale, sand & lime	1455
red bed & shale	2107
lime & shale	2417
lime w/shale stks	2539
lime & shale	4028
lime	4145
lime & shale	4403
lime	4497
lime & shale	4614
lime	4734
lime & shale	4491
chert	5034
chert & lime	5068
lime	5100
Total Depth	

TOPS:	
Heebner	4142
Toronto	4154
Douglas	4174
Brown Lime	4318
Lansing	4329
Marmaton	4754
Mississippi Chat	4941
Mississippi Lime	5048

RECEIVED
STATE CORPORATION COMMISSION
SEP 27 1971
CONSERVATION DIVISION
Wichita, Kansas