


15-097-10062-0000

STATE OF KANSAS
STATE CORPORATION COMMISSION

Give All Information Completely
Make Required Affidavit
Mail or Deliver Report to:
Conservation Division
State Corporation Commission
211 No. Broadway
Wichita, Kansas

WELL PLUGGING RECORD

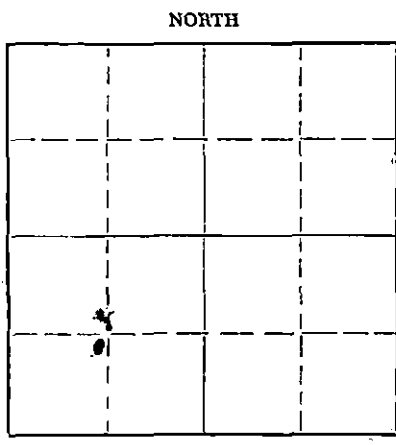

Locate well correctly on above Section Plat

Kiowa County. Sec. 16 Twp. 29S Rge. 18(W)
Location as "NE/CNWxSWx" or footage from lines 1251' NSL & 1251' EWL of SW/4
Lease Owner Gulf Oil Corporation
Lease Name A. E. Peters Well No. 1
Office Address Box 661, Tulsa, Oklahoma
Character of Well (completed as Oil, Gas or Dry Hole) Dry Hole
Date well completed 11-26 1957
Application for plugging filed 11-26 1957
Application for plugging approved (Verbally) 11-26 1957
Plugging commenced 11-26 1957
Plugging completed 11-26 1957
Reason for abandonment of well or producing formation Dry Hole

If a producing well is abandoned, date of last production - - 19
Was permission obtained from the Conservation Division or its agents before plugging was commenced? Yes

Name of Conservation Agent who supervised plugging of this well
Producing formation Dry Depth to top Bottom Total Depth of Well 5001 Feet
Show depth and thickness of all water, oil and gas formations.

OIL, GAS OR WATER RECORDS

CASING RECORD

FORMATION	CONTENT	FROM	TO	SIZE	PUT IN	PULLED OUT
				8-5/8"	412'	0

Describe in detail the manner in which the well was plugged, indicating where the mud fluid was placed and the method or methods used in introducing it into the hole. If cement or other plugs were used, state the character of same and depth placed, from feet to feet for each plug set.
Filled hole with mud to 350' of surface. Spotted 1/2 sack hulls and 20 sacks cement.
Filled with mud to 35' of surface. Spotted 1/2 sack hulls and capped with 10 sacks cement, filling hole into cellar.

NOTE: W. C. Bunch - Special Petty Cash, Check No. 1908, dated 12-6-57, in the amount of \$50.01, is attached as payment of Plugging Assessment.

Attached is Driller's Formation Record which was not available at time Application was filed.

12-12-57 DEC 12 1957
RECEIVED
CONSERVATION DIVISION
Wichita, Kansas
DEC 7 1957

(If additional description is necessary, use BACK of this sheet)
Name of Plugging Contractor Falcon Seaboard Drilling Company
Address Pan American Building, Tulsa, Oklahoma

STATE OF Kansas COUNTY OF Sedgwick, ss.
~~XXXXXXXXXX~~ Lloyd L. Gray (employee of owner) ~~XXXXXXXXXX~~ of the above-described well, being first duly sworn on oath, says: That I have knowledge of the facts, statements, and matters herein contained and the log of the above-described well as filed and that the same are true and correct. So help me God.

(Signature) Lloyd L. Gray
Box 2233, Wichita, Kansas
(Address)

SUBSCRIBED AND SWORN to before me this 6th day of December, 1957

C. C. LEWIS, NOTARY PUBLIC
Notary Public.

My commission expires 6-3-61

JRM:PF

PLUGGING
FILE SEC 16 T29 184
BOOK PAGE 64 LINE 6

WELL LOG

COMPANY: Gulf Oil Corporation

Sec. 16-29S-18W

FARM: A. E. Peters No. 1

Loc. SW $\frac{1}{4}$

TOTAL DEPTH: 5,001'

County - Kiowa

COMM: 11-9-57. COMP: 11-26-57.

CASING

8-5/8" - 411.50'

ELEVATION

D.F. -
Gr. -

DRILLER'S LOG

Clay, Sand, Shale & Red Bed	0	382
Red Bed	382	412
Clay & Shale	412	1244
Shale & Lime	1244	2490
Lime	2490	3090
Lime & Shale	3090	3884
Lime	3884	4108
Lime & Shale	4108	4385
Lime	4385	4687
Lime & Shale	4687	4750
Lime	4750	4839
Lime, Shale & Chert	4839	4919
Lime	4919	4941
Lime & Chert	4941	4954
Lime	4954	5001
Total Depth		5001

STATE OF KANSAS
 DEC 7 1957
 CONSERVATION DIVISION
 W. H. BRADSHAW

PLUGGING
 FILE SEC 16 T. 29 R. 18W
 BOOK PAGE 64 LINE 6