


STATE OF KANSAS
STATE CORPORATION COMMISSION

Give All Information Completely
Make Required Affidavit
Mail or Deliver Report to:
Conservation Division
State Corporation Commission
211 No. Broadway
Wichita, Kansas

WELL PLUGGING RECORD

Kiowa County. Sec. 35 Twp. 29S Rge. 18W (E) (W)
Location as "NE/CNW%SW%" or footage from lines c SW NE
Lease Owner Kenneth Rupp
Lease Name NICHOLS Well No. -1-
Office Address 1035 Wichita Plaza Bldg., Wichita, Kansas
Character of Well (completed as Oil, Gas or Dry Hole) dry hole
Date well completed December 29, 1965 19
Application for plugging filed December 29, 1965 19
Application for plugging approved December 29, 1965 19
Plugging commenced December 29, 1965 19
Plugging completed December 30, 1965 19
Reason for abandonment of well or producing formation dry hole

NORTH

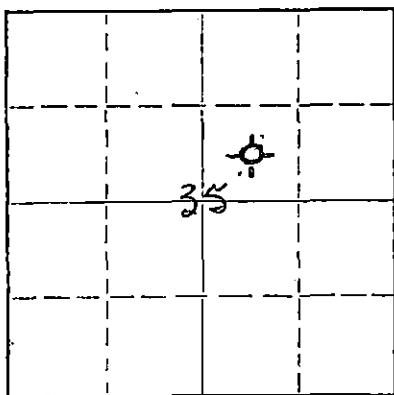

Locate well correctly on above Section Plat

If a producing well is abandoned, date of last production -- 19
Was permission obtained from the Conservation Division or its agents before plugging was commenced? yes

Name of Conservation Agent who supervised plugging of this well Archie Elving
Producing formation -- Depth to top -- Bottom -- Total Depth of Well 4800 Feet
Show depth and thickness of all water, oil and gas formations.

OIL, GAS OR WATER RECORDS

CASING RECORD

FORMATION	CONTENT	FROM	TO	SIZE	PUT IN	PULLED OUT
				8-5/8"	400'	---

Describe in detail the manner in which the well was plugged, indicating where the mud fluid was placed and the method or methods used in introducing it into the hole. If cement or other plugs were used, state the character of same and depth placed, from feet to feet for each plug set.

plug and 25 sacks cement at 300 feet and
plug and 10 sacks cement at 40 feet

RECEIVED
STATE CORPORATION COMMISSION

1-10-66 JAN 10 1966

(If additional description is necessary, use BACK of this sheet)


Name of Plugging Contractor E. K. Edmiston Drilling Co., Inc.
Address 425 First National Bank Building, Wichita, Kansas 67202

STATE OF KANSAS COUNTY OF SEDGWICK
E. K. Edmiston (employee or owner) owner of the above-described well, being first duly sworn on oath, says: That I have knowledge of the facts, statements, and matters herein contained and the log of the above-described well as filed and that the same are true and correct. So help me God.

(Signature) E. K. Edmiston
425 First National Bank Bldg.
Wichita, Kansas (Address)

SUBSCRIBED AND SWORN TO before me this 4th day of January, 19 66

My commission expires August 25, 1968
A. B. Barger
A. B. Barger Notary Public.

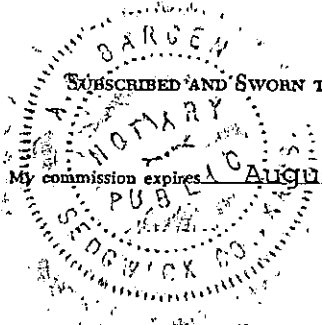

DRILLER'S LOG

Company: Kenneth Rupp
1035 Wichita Plaza Building
Wichita, Kansas 67202

Rotary Drilling Commenced: December 14, 1965

Rotary Drilling Completed: December 30, 1965

Well Name: NICHOLS No. 1
C SW NE 35-29S-18W
Kiowa County, Kansas

Contractor: E. K. Edmiston Drilling Co., Inc.
425 First National Bank Building
Wichita, Kansas 67202

Casing Record: 400' of 8-5/8" with 280 sacks Pozmix

L O G

Measurements from top of Kelly bushing

Clay	0 - 40
Shale	200
Shale and Shells	350
Red Bed	530
Red Bed and Shale	1124
Shale	1337
Shale and Shells	2092
Shale	2245
Lime and Shale	2370
Lime	2985
Lime and Shale	3260
Shale and Lime	3875
Lime and Shale	4073
Shale and Lime	4214
Lime and Shale	4448
Lime	4800 RTD

The undersigned, E. K. Edmiston, President of E. K. Edmiston Drilling Co., Inc., hereby certifies on behalf of said company that the above log is a true and correct log of the formations encountered in drilling the above well, as reflected by the daily drilling reports.


E. K. EDMISTON DRILLING CO., INC.

By: 
E. K. Edmiston, President

STATE OF KANSAS,
SS:
SEDGWICK COUNTY,

BE IT REMEMBERED that on this 4th day of January, 1966, before me, the undersigned, a Notary Public in and for said county and state, came E. K. Edmiston, known to me to be the same person who executed the foregoing instrument as President and on behalf of the E. K. Edmiston Drilling Co., Inc., and he duly acknowledged the execution of the same for himself and for said company.

IN WITNESS WHEREOF, I have hereunto set my hand and official seal on the day and year last above written.

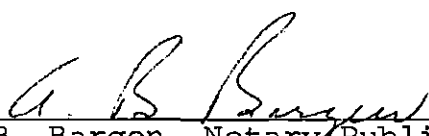
A. B. Bargaen, Notary Public

My commission expires
August 25, 1968

