

STATE OF KANSAS
STATE CORPORATION COMMISSION


Give All Information Completely
Make Required Affidavit
Mail or Deliver Report to:
Conservation Division
State Corporation Commission
800 Bittling Building
Wichita, Kansas

WELL PLUGGING RECORD

Kiowa County, Sec. 32 Twp. 29S Rge. (E) 18 (W)

Location as "NE/CNW%SW%" or footage from lines C SE NE NE
Lease Owner Falcon Seaboard Drilling Company
Lease Name BROWN Well No. 2
Office Address Pan American Bldg., Tulsa, Oklahoma.
Character of Well (completed as Oil, Gas or Dry Hole) Dry Hole
Date well completed June 8, 19 59
Application for plugging filed June 8, 19 59
Application for plugging approved June 9, 19 59
Plugging commenced June 8, 19 59
Plugging completed June 8, 19 59
Reason for abandonment of well or producing formation _____

NORTH

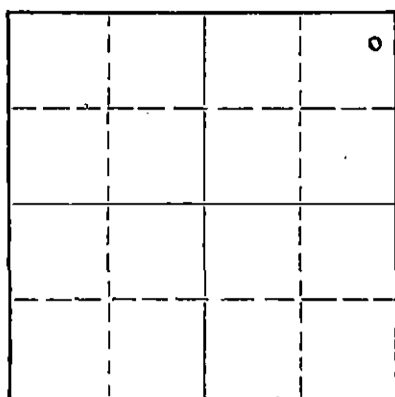

Locate well correctly on above
Section Plat

If a producing well is abandoned, date of last production _____ 19____
Was permission obtained from the Conservation Division or its agents before plugging was commenced? _____

Name of Conservation Agent who supervised plugging of this well J. Lewis Brock, Great Bend, Kansas
Producing formation _____ Depth to top _____ Bottom _____ Total Depth of Well _____ Feet
Show depth and thickness of all water, oil and gas formations.

OIL, GAS OR WATER RECORDS

CASING RECORD

FORMATION	CONTENT	FROM	TO	SIZE	PUT IN	PULLED OUT
				8-5/8"	457	None

Describe in detail the manner in which the well was plugged, indicating where the mud fluid was placed and the method or methods used in introducing it into the hole. If cement or other plugs were used, state the character of same and depth placed, from _____ feet to _____ feet for each plug set.

Hole was filled w/heavy mud, pushed plug to 425' and dumped 20 sacks of cement on top of plug. Filled hole w/mud to 35' and pushed plug to 35' and dumped 10 sacks cement, filling to top of 8-5/8" casing.

RECEIVED
STATE CORPORATION COMMISSION

JUN 13 1959 7-13-59

CONSERVATION DIVISION
Wichita, Kansas

(If additional description is necessary, use BACK of this sheet)

Name of Plugging Contractor Company Tools
Address _____

STATE OF OKLAHOMA, COUNTY OF TULSA, ss.
J. O. BROWN (employee of owner) or (owner or operator) of the above-described well, being first duly sworn on oath, says: That I have knowledge of the facts, statements, and matters herein contained and the log of the above-described well as filed and that the same are true and correct. So help me God.

(Signature) J. O. Brown

(Address) _____

SUBSCRIBED AND SWORN to before me this 12th day of June, 19 59

Dalores Walsh

My commission expires February 8, 1962.

Notary Public.

PLUGGING
FILE SEC. 32 T. 29 R. 18W
BOOK PAGE 44 LINE 16

WELL LOG

COMPANY: Falcon Seaboard Drilling Company

Sec. 32-29S-18W

FARM: Brown No. 2

Loc. C SE NE NE

TOTAL DEPTH: 5,030'

County - Kiowa

COMM: 5-20-59. COMP: 6-8-59.

CASING

8-5/8" - 457.19'

ELEVATION

D.F. - 2,222'

Gr. - 2,215'

DRILLER'S LOG

Surface Soil & Red Bed	0	160
Red Bed, Shale & Shells	160	564
Red Bed & Shale	564	874
Red Bed & Shells	874	1150
Red Bed & Shale	1150	1968
Red Bed & Lime Shells	1968	2220
Lime & Shale	2220	2313
Lime	2313	2328
Lime & Shale	2328	2492
Lime	2492	2557
Lime & Shale	2557	4067
Lime	4067	4131
Lime & Shale	4131	4417
Lime	4417	4568
Lime & Shale	4568	4590
Lime	4590	4677
Lime & Shale	4677	4709
Lime	4709	4755
Lime & Shale	4755	4905
Lime	4905	4954
Lime & Chert	4954	4985
Lime	4985	5030
Total Depth		5030

RECEIVED
STATE CORPORATION COMMISSION

JUN 18 1959

CONSERVATION DIVISION
Wichita, Kansas

PLUGGING
FILE SEC. 32-29-18W
BOOK PAGE 46 LINE 26