


Give All Information Completely  
Make Required Affidavit  
Mail or Deliver Report to:  
Conservation Division  
State Corporation Commission  
211 No. Broadway  
Wichita, Kansas

WELL PLUGGING RECORD

NORTH

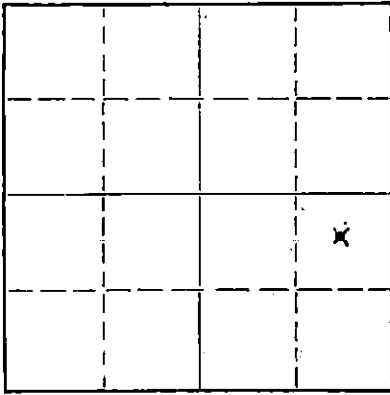

Locate well correctly on above  
Section Plat

Kingman County. Sec. 1 Twp. 28 Rge. 9 (SW) (W)  
Location as "NE/CNW/SW" or footage from lines G, NE SE  
Lease Owner Mull Drlg. Co. Inc.  
Lease Name Matt Giefer Well No. 1  
Office Address 670 N. 14th. Natl. Bank Bldg. Wichita, Kansas  
Character of Well (completed as Oil, Gas or Dry Hole) Dry Hole  
Date well completed 9-3 1960  
Application for plugging filed 9-3 1960  
Application for plugging approved 9-3 1960  
Plugging commenced 3:00 A.M. 9-3 1960  
Plugging completed 4:00 A.M. 9-3 1960  
Reason for abandonment of well or producing formation  
Non productive.  
If a producing well is abandoned, date of last production 19  
Was permission obtained from the Conservation Division or its agents before plugging was commenced? Yes

Name of Conservation Agent who supervised plugging of this well W. L. Lac Kamp Jr.  
Producing formation \_\_\_\_\_ Depth to top \_\_\_\_\_ Bottom \_\_\_\_\_ Total Depth of Well 4324' Feet  
Show depth and thickness of all water, oil and gas formations.

OIL, GAS OR WATER RECORDS

CASING RECORD

FORMATION	CONTENT	FROM	TO	SIZE	PUT IN	PULLED OUT

Describe in detail the manner in which the well was plugged, indicating where the mud fluid was placed and the method or methods used in introducing it into the hole. If cement or other plugs were used, state the character of same and depth placed, from \_\_\_\_\_ feet to \_\_\_\_\_ feet for each plug set.

Hole filled with drilling mud to within 210' of surface. Plug was pushed to this depth and 1/2 sack hulls dumped on top of plug. 20 sacks cement was put on top of plug through drill pipe. Hole was filled to within 30' of top and plug was pushed to this depth, 1/2 sack hulls put on top of plug. 10 sacks cement was put on top of plug through drill pipe, this completed plugging hole. 2 sacks cement was put in rat hole bridging same.

RECEIVED  
STATE CORPORATION COMMISSION

SEP 9 1960

CONSERVATION DIVISION  
Wichita, Kansas

9-9-1960

(If additional description is necessary, use BACK of this sheet)

Name of Plugging Contractor \_\_\_\_\_  
Address \_\_\_\_\_

STATE OF KANSAS, COUNTY OF SEDGWICK, ss.  
Joseph O. Butts (employee of owner) or ~~owner or operator~~ of the above-described well, being first duly sworn on oath, says: That I have knowledge of the facts, statements, and matters herein contained and the log of the above-described well as filed and that the same are true and correct. So help me God.

(Signature) Joseph O. Butts

SUBSCRIBED AND SWORN TO before me this 6th day of September, 19 60

My commission expires January 28, 1961

(Address) \_\_\_\_\_  
Ethel Zimmerman  
Ethel Zimmerman Notary Public.



