


WELL PLUGGING RECORD

Give All Information Completely
Make Required Affidavit
Mail or Deliver Report to:
Conservation Division
State Corporation Commission
800 Bittling Building
Wichita, Kansas

Kingman County. Sec. 35 Twp. 28 Rge. 8W (E) (W)

Location as "NE/CNW/SW" or footage from lines NE NE SE
Lease Owner Ute Royalty Corp.
Lease Name Biggs Well No. 1
Office Address Box 9338, Ft. Worth, Texas
Character of Well (completed as Oil, Gas or Dry Hole) Dry hole
Date well completed 12/24 19 54
Application for plugging filed 12/24 verbally 19 54
Application for plugging approved 12/24 verbally 19 54
Plugging commenced 12/24 19 54
Plugging completed 12/24 19 54
Reason for abandonment of well or producing formation _____

NORTH

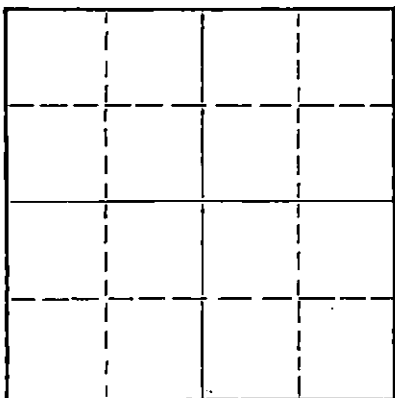

Locate well correctly on above Section Flat

If a producing well is abandoned, date of last production _____ 19 ____
Was permission obtained from the Conservation Division or its agents before plugging was commenced? Yes

Name of Conservation Agent who supervised plugging of this well Ruel Durkee
Producing formation _____ Depth to top _____ Bottom _____ Total Depth of Well 4473 Feet
Show depth and thickness of all water, oil and gas formations.

OIL, GAS OR WATER RECORDS

CASING RECORD

FORMATION	CONTENT	FROM	TO	SIZE	PUT IN	PULLED OUT
				8 5/8"	125'	None

Describe in detail the manner in which the well was plugged, indicating where the mud fluid was placed and the method or methods used in introducing it into the hole. If cement or other plugs were used, state the character of same and depth placed, from _____ feet to _____ feet for each plug set.

Ran pipe one-half way to bottom, gun pits and circulate heavy mud. Plug and rock bridge @ 240', 25 sacks of cement through 7 joints of pipe. Filled with heavy mud. Plug and 5 sacks of cement @ top of 8 5/8".

12-29-54

(If additional description is necessary, use BACK of this sheet)

Name of Plugging Contractor _____
Address _____

STATE OF KANSAS, COUNTY OF RUSSELL, ss.
Harold Wurst (employee of owner) or (owner or operator) of the above-described


well, being first duly sworn on oath, says: That I have knowledge of the facts, statements, and matters herein contained and the log of the above-described well as filed and that the same are true and correct. So help me God.

(Signature) Harold Wurst
Russell, Ks.
(Address)

SUBSCRIBED AND SWORN to before me this 28th day of December, 19 54

My commission expires 6/17/58

Notary Public.

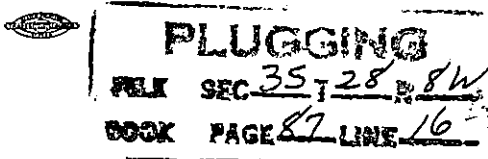

15-695-60400-0000

WELL LOG

UTE ROYALTY CORP.
Biggs #1

NE NE SE Sec. 35-28-8
Kingman County, Kans.

RTD 4473
Comm: 12/5/54
Comp: 12/24/54

Drilled by Bennett & Roberts Drilling, Inc. 8 5/8" Set @ 125' w/100' sx cmt.

----- Figures Indicate Bottom of Formation -----

Sand & Clay	75'
Red Bed	650
Shale & Shells	710
Anhydrite	745
Shale & Shells	900
Salt	1050
Shale & Shells	1250
Lime & Shale	1450
Shale & Shells	1630
Lime & Shale	3233
Sand	3271
Sandy Lime & Shale	3365
Lime	3369
Lime & Shale	3431
Lime	3575
Lime & Shale	3614
Lime	3801
Shale & Lime	3870
Lime	3919
Lime & Shale	4020
Lime	4150
Cherty Lime	4208
Chert	4227
Lime & Shale	4251
Lime	4273
Shale	4280
Shale & Lime	4317
Lime & Shale streaks	4380
Lime	4460
Lime & Sand	4473

STATE OF KANSAS)
COUNTY OF RUSSELL) SS.

I hereby certify that the above information is correct to the best of my knowledge.

BENNETT & ROBERTS DRILLING, INC.

By John R. Quinn

Subscribed and sworn to before me this 28th day of December, 1954.

Clara Hummel
Notary Public

My Commission Expires 6/17/58.

PLUGGING
WELL SEC 35 28 8N
BOOK PAGE 17 LINE 16