

STATE OF KANSAS
STATE CORPORATION COMMISSION

WELL PLUGGING RECORD


Give All Information Completely
Make Required Affidavit
Mail or Deliver Report to:
Conservation Division
State Corporation Commission
800 Bittling Building
Wichita, Kansas

OR

FORMATION PLUGGING RECORD

Strike out upper line
when reporting plug-
ging of formations.

NORTH

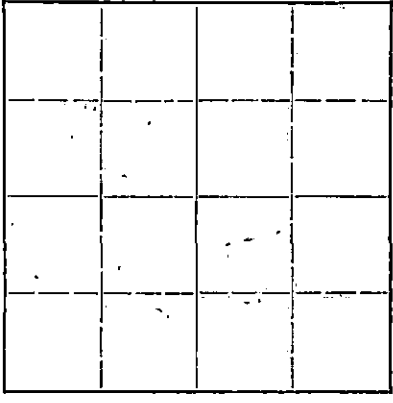

Locate well correctly on above
Section Plat

Kingman County, Sec. 35 Twp. 28 Rge. (E) 7 (W)
Location as "NE 1/4 NW 1/4 SW 1/4" or footage from lines Center N. E. 1/4
Lease Owner. Miller / Harbar Drilling Co. Etal
Lease Name. Miller Well No. I
Office Address. 1019 Central Bldg. Wichita, Kansas
Character of Well (completed as Oil, Gas or Dry Hole) Rotary Dry Hole
Date well completed. 4/3/48 19
Application for plugging filed. 4/3/48 19
Application for plugging approved. 4/3/48 19
Plugging commenced. 4/4/48 19
Plugging completed. 4/4/48 19
Reason for abandonment of well or producing formation. Dry Hole

If a producing well is abandoned, date of last production. X 19
Was permission obtained from the Conservation Division or its agents before plugging was com-
menced? Yes

Name of Conservation Agent who supervised plugging of this well. C. D. Stough
Producing formation. None Depth to top. X Bottom. X Total Depth of Well. 4568 Feet
Show depth and thickness of all water, oil and gas formations.

OIL, GAS OR WATER RECORDS

CASING RECORD

Formation	Content	From	To	Size	Put In	Pulled Out
Surface sand & Gravel	Water	0	180'	10 3/4"	263'	None

Describe in detail the manner in which the well was plugged, indicating where the mud fluid was placed and the method or methods used in introducing it into the hold. If cement or other plugs were used, state the character of same and depth placed, from _____ feet to _____ feet for each plug set.

Set Wood plug at 260' and dumped 20 Sx. cement pumped heavy mud on top cement to 20' of top hole. Set wood plug at 20' and dumped 10 sX. cement filling top surface pipe and bottom cellar with cement.

Hole was filled with heavy mud from bottom to wood plug which was set at 260'

APR 12 1948

(If additional description is necessary, use BACK of this sheet)

Correspondence regarding this well should be addressed to Harbar Drilling Co.
Address. 1019 Central Bldg. Wichita Kansas 4-12-1948

STATE OF Kansas COUNTY OF Barton SS.
I Roy Cook (employee of owner) or (owner or operator) of the above-described well,

being first duly sworn on oath, says: That I have knowledge of the facts, statements, and matters herein contained and the log of the above-described well as filed and that the same are true and correct. So help me God.

(Signature) Roy Cook

SUBSCRIBED AND SWORN to before me this 8th day of April, 1948

My commission expires 9-4-50 (Address) Roy Gillig Notary Public.

PLUGGING
FILE SEC 35 T 28 R 7 W
BOOK PAGE 20

15-095-00446-0600

MILLER #1

Center NE $\frac{1}{4}$ Sec. 35-28-7W, Kingman County, Kansas

Started rigging up Rotary Tools 3/4/48
 Finished tearing out Rotary Tools 4/4/48

Run 9 Jts 10 3/4" surface pipe.
 Set @ 263'. Cemented with 125 sx. cement

<u>FORMATION</u>	<u>FROM</u>	<u>TO</u>
Sand	0	50
Red Bed	50	549
Red bed and shells	549	780
Salt shells	780	930
Shale and shells	930	1070
Shale, shells & Anhydrite	1070	1320
Shale and lime	1320	1360
Sandy lime	1360	1410
Lime and shale	1410	1565
Lime, broken	1565	1635
Lime and shale	1635	2185
Shale	2185	2195
Shale and shells	2195	2480
Sandy lime	2480	2533
Lime and shale	2533	2690
Shale	2690	2770
Shale and lime	2770	3100
Shale	3100	3119
Lime and shale	3119	3157
Sand	3157	3238
Lime	3238	3355
Lime and shale	3355	3425
Lime	3425	3755
Shale and lime	3755	4010
Shale	4010	4035
Lime	4035	4045
Lime and Chert	4045	4145
Shale and lime	4145	4240
Shale	4240	4280
Lime and shale	4280	4300
Sandy lime	4300	4310
Shale and lime	4310	4415
Shale	4415	4435
Lime	4435	4448
Sand and shale	4448	4495
Shale, lime and sand	4495	4530
Shale	4530	4546
Lime	4546	4568 Total Depth

APR 2 1948

I, Don S. Packer, hereby certify that the above Log is true and correct, to the best of my knowledge and belief.

Subscribed and sworn to before me this 12th day of April, 1948.

My commission expires:

Nov 23, 1950

Don S. Packer

Mary C. Brown
 Notary Public

PLUGGING
 FILE SEC. 35-28-7W
 BOOK PAGE 20 LINE 33