


WELL PLUGGING RECORD

Give All Information Completely
Make Required Affidavit
Mail or Deliver Report to:
Conservation Division
State Corporation Commission
212 North Market, Insurance Bldg.
Wichita, Kansas

NORTH

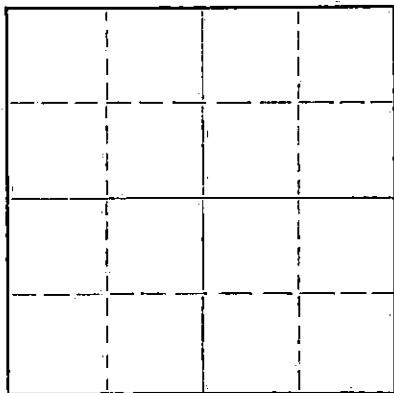

Locate well correctly on above
Section Plat

Kingman County, Sec. 23 Twp. 28 Rge. 7 (E) W. (W)
Location as "NE/CNW/SW" or footage from lines Gen. SW NW SE
Lease Owner Cities Service Oil Company
Lease Name Chase Well No. 2
Office Address Box 144, Great Bend, Kansas
Character of Well (completed as Oil, Gas or Dry Hole) Dry Hole
Date well completed April 29 19 60
Application for plugging filed April 29 19 60
Application for plugging approved April 29 19 60
Plugging commenced April 30 19 60
Plugging completed April 30 19 60
Reason for abandonment of well or producing formation Dry Hole

If a producing well is abandoned, date of last production - 19 -
Was permission obtained from the Conservation Division or its agents before plugging was commenced? Yes

Name of Conservation Agent who supervised plugging of this well Fred W. Hempel
Producing formation None Depth to top - Bottom - Total Depth of Well 3697 Feet
Show depth and thickness of all water, oil and gas formations.

OIL, GAS OR WATER RECORDS

CASING RECORD

FORMATION	CONTENT	FROM	TO	SIZE	PUT IN	PULLED OUT
				8-5/8"	408'	None

Describe in detail the manner in which the well was plugged, indicating where the mud fluid was placed and the method or methods used in introducing it into the hole. If cement or other plugs were used, state the character of same and depth placed, from _____ feet to _____ feet for each plug set.

3697-300', mud.
300-255', wood plug, hulls and 15 sacks cement.
255- 35', mud.
35' to base of cellar, wood plug, hulls and 10 sacks cement.

2 sacks cement in rat hole.

RECEIVED
STATE CORPORATION COMMISSION

MAY 12 1960

CONSERVATION DIVISION
Wichita, Kansas

5-12-1960

(If additional description is necessary, use BACK of this sheet)
Name of Plugging Contractor Lohmann-Johnson Drilling Co., Inc.
Address 320 Indiana Bank Bldg., Evansville 8, Indiana

STATE OF Kansas, COUNTY OF Barton, ss.
John D. Forsyth (employee of owner) or owner/proprietor of the above-described well, being first duly sworn on oath, says: That I have knowledge of the facts, statements, and matters herein contained and the log of the above-described well as filed and that the same are true and correct. So help me God.

(Signature) John D. Forsyth
Box 144, Great Bend, Kansas
(Address)

SUBSCRIBED AND SWORN to before me this 10th day of May, 19 60

W. B. Smith
Notary Public.

My commission expires March 12, 1963.

WELL RECORD

15-095-01336-0000

WILDCAT.....
 DISCOVERY.....
 POOL.....
 COMPANY Cities Service Oil Co. WELL # 2 FARM Chase
 LOCATION 940' South and 330' East of Center
Section 23, Township 28, Range 7W
 ELEV. 1559 CO. Kingman STATE Kansas
 IP. Dry Hole. P. and A. April 29, 1960.
 PERFS.....
 FRAC..... ACID None
 T.D. 3697' P.B.T.D..... GRAV/GOR.....
 DRLG. COMM. April 18, 1960 COMP. April 28, 1960 CONTRACTOR Lohmann & Johnson Drlg. Co., Inc.

CASING RECORD:

8-5/8" at 408' with 275 sacks cement.

FORMATION RECORD:

sand and red rock	0-100
shale and sand	410
red bed, shale & lime	1301
lime	1525
lime and shale	1915
shale	2470
shale and lime	2680
lime	2888
lime and shale	3047
lime	3665
lime and shale	3697

Heebner	2965
Douglas	2995
Brown Limestone	3210
Lansing	3221
Base Kansas City	3681
T.D.	3697

D.S.T. 3572-96, open 1 hour, recovered 45' mud with trace oil; B.H.P. 590# in 30 minutes.

D.S.T. 3599-3620, open 1 hour, recovered 186' oily mud, 31' muddy oil, 62' oily salt water, and 217' slightly muddy salt water; I.B.H.P. 1300# in 30 minutes, F.B.H.P. 1280# in 30 minutes.

D.S.T. 3649-65, open 1 hour, recovered 1493' salt water; B.H.P. 1500# in 30 minutes.

Slope Tests (Sperry-Sun):

409' - 1/2"
 1270' - 2"
 2000' - 1"
 2500' - 1-3/4"

RECEIVED
 STATE CORPORATION COMMISSION

MAY 12 1960

CONSERVATION DIVISION
 Wichita, Kansas