

WELL PLUGGING RECORD

Give All Information Completely
Make Required Affidavit
Mail or Deliver Report to:
Conservation Division
State Corporation Commission
211 No. Broadway
Wichita, Kansas

Kingman County. Sec. 23 Twp. 28S Rge. 7W (E) (W)

Location as "NE/CNW%SW%" or footage from lines W/2 NE SE

Lease Owner BACHUS OIL COMPANY

Lease Name CHASE Well No. #1-A

Office Address 721 East Central, Wichita 2, Kansas

Character of Well (completed as Oil, Gas or Dry Hole) Dry Hole

Date well completed 7-16 1959

Application for plugging filed 7-17 1959

Application for plugging approved 7-17 By Telephone 1959


Plugging commenced 7-17 1959

Plugging completed 7-17 1959

Reason for abandonment of well or producing formation No production in commercial quantities

If a producing well is abandoned, date of last production 19

Was permission obtained from the Conservation Division or its agents before plugging was commenced? Yes

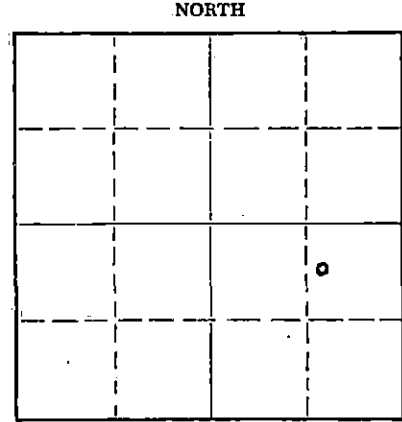

Locate well correctly on above Section Plat

Name of Conservation Agent who supervised plugging of this well Fred W. Hample

Producing formation _____ Depth to top _____ Bottom _____ Total Depth of Well 3819 Feet

Show depth and thickness of all water, oil and gas formations.

OIL, GAS OR WATER RECORDS

CASING RECORD

| FORMATION | CONTENT | FROM | TO | SIZE | PUT IN | PULLED OUT |
|-----------|---------|------|----|--------|--------|------------|
| | | | | 8 5/8" | 252' | |
| | | | | | | |
| | | | | | | |
| | | | | | | |
| | | | | | | |
| | | | | | | |
| | | | | | | |
| | | | | | | |
| | | | | | | |

Describe in detail the manner in which the well was plugged, indicating where the mud fluid was placed and the method or methods used in introducing it into the hole. If cement or other plugs were used, state the character of same and depth placed, from _____ feet to _____ feet for each plug set.

Filled hole with heavy mud to 240'. Globe Oil Well Cementing Co. set plug with 35 sacks cement @ 240'. Filled hole to 45' with heavy mud and set plug with 15 sacks cement.

RECEIVED
STATE CORPORATION COMMISSION
JUL 22 1959
CONSERVATION DIVISION
Wichita, Kansas

7-22-1959

(If additional description is necessary, use BACK of this sheet)

Name of Plugging Contractor BACHUS OIL COMPANY

Address 721 East Central, Wichita, Kansas

STATE OF Kansas, COUNTY OF Sedgwick, ss. Wm. A. Cecil, General Mgr. (employee of owner) or (owner or operator) of the above-described well, being first duly sworn on oath, says: That I have knowledge of the facts, statements, and matters herein contained and the log of the above-described well as filed and that the same are true and correct. So help me God.

(Signature) Wm. A. Cecil Gen Mgr.
721 East Central, Wichita, Kansas (Address)

SUBSCRIBED AND SWORN to before me this 21st day of July, 1959

My commission expires 10-19-60

Gail L. Thyfault Notary Public.

PLUGGING
FILE SEC 23 T 28 R 24
BOOK PAGE 52 LINE 7

15-095-01334-0000

DRILLING LOG

COMPANY: Bachus Oil Company
 721 East Central
 Wichita, Kansas

LEASE: CHASE

WELL: #1-A

LOCATION: W/2 NE SE of Section 23-28S-7W
 Kingman County, Kansas

DATE COMM: 7-6-59

COMP: 7-16-59

T.D.: 3819'

CASING: 8 5/8" to 252' w/175 sacks common cement 2% CaCl.

Figures Indicate the Bottom of Formation

| | |
|------|---------------------------|
| 0-20 | Red Rock |
| 40 | Sand |
| 230 | Red Bed |
| 805 | Red Bed, Shale and Shells |
| 980 | Shale and Shells |
| 1010 | Anhydrite and Shells |
| 1120 | Shale and Lime |
| 1240 | Lime and Shale |
| 1610 | Lime |
| 2105 | Lime and Shale |
| 2475 | Shale and Lime |
| 2600 | Lime and Shale |
| 2635 | Topeka Lime |
| 2960 | Lime |
| 3120 | Sandy Shale and Lime |
| 3211 | Sandy Lime and Shale |
| 3219 | Brown Lime |
| 3230 | Kansas City Lime |
| 3680 | Lime |
| 3730 | Lime and Shale |
| 3819 | Lime and Shale |

RECEIVED
 STATE CORPORATION COMMISSION
 AUG 3 1959
 CONSERVATION DIVISION
 Wichita, Kansas

I certify the above to be true and correct to the best of my knowledge and belief.

BACHUS OIL COMPANY

BY Wm. A. Cecil
Wm. A. Cecil, Gen. Mgr.

Subscribed and sworn before me this 21st day of July, 1959.

My Commission Expires:

October 19, 1960

Gail L. Thyfault
 Gail L. Thyfault, Notary Public

PLUGGING
 FILE SEC. 23... T. 28... R. 7W
 BOOK PAGE 50 LINE 7