


Give All Information Completely
Make Required Affidavit
Mail or Deliver Report to:
Conservation Division
State Corporation Commission
212 No. Market
Wichita, Kansas

WELL PLUGGING RECORD 15-095-19033-0000

Kingman County. Sec. 18 Twp. 28 Rge. 7W (E) (W)

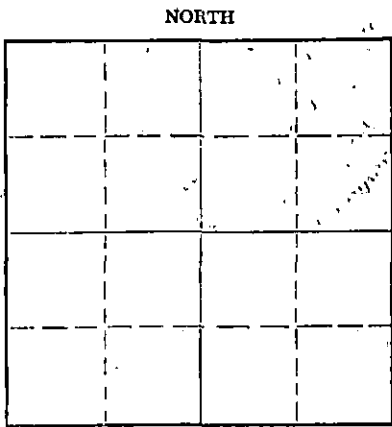

Locate well correctly on above Section Plat

Location as "NE/CNW/SW" or footage from lines NE SW NW
Lease Owner Pomlinson Oil Co., Inc.
Lease Name Prather #2 Well No. _____
Office Address Wichita, Kansas 67202
Character of Well (completed as Oil, Gas or Dry Hole) _____
Date well completed _____ 19____
Application for plugging filed _____ 19____
Application for plugging approved _____ 19____
Plugging commenced 12/13/69 _____ 19____
Plugging completed 12/15/69 _____ 19____
Reason for abandonment of well or producing formation depleted.

If a producing well is abandoned, date of last production _____ 19____
Was permission obtained from the Conservation Division or its agents before plugging was commenced? yes

Name of Conservation Agent who supervised plugging of this well Justice
Producing formation _____ Depth to top _____ Bottom _____ Total Depth of Well 3705' Feet
Show depth and thickness of all water, oil and gas formations.

OIL, GAS OR WATER RECORDS

CASING RECORD

FORMATION	CONTENT	FROM	TO	SIZE	PUT IN	PULLED OUT
				8-5/8	533'	none
				4 1/2"	3700'	3297'

Describe in detail the manner in which the well was plugged, indicating where the mud fluid was placed and the method or methods used in introducing it into the hole. If cement or other plugs were used, state the character of same and depth placed, from _____ feet to _____ feet for each plug set.

Checked hole, set 4 sacks of cement on bottom. Rigged up on 4 1/2", loaded hole with water. Shot pipe at 3314', worked pipe loose and pulled 104 joints. Bailed hole to 300' rock bridge and ran 25 sacks of cement. Mudded to 40' rock bridge and ran 10 sacks of cement. Tallied pipe, cut off braden head.

PLUGGING COMPLETE.


RECEIVED
STATE CORPORATION COMMISSION
JAN 13 1970
CONSERVATION DIVISION
Wichita, Kansas

Name of Plugging Contractor KNIGHT CASING PULLING CO., INC.
Address CHASE, KANSAS

STATE OF KANSAS COUNTY OF RICE, ss.
NOEL J. KNIGHT (employee of owner) or (owner or operator) of the above-described well, being first duly sworn on oath, says: That I have knowledge of the facts, statements, and matters herein contained and the log of the above-described well as filed and that the same are true and correct. So help me God.

(Signature) [Signature]
CHASE, KANSAS (Address)

Subscribed and Sworn to before me this 16th day of December, 19 69

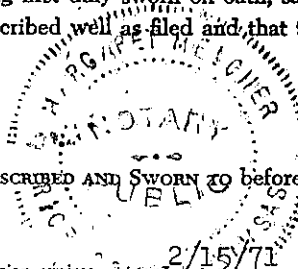

[Signature]
Notary Public.

My commission expires 2/15/71

15-095-19033-0000

DRILLERS LOG
B. H. HILBURN
2 PRATHER
NE SW NW, SEC. 18-28S-7W
KINGMAN COUNTY, KANSAS

Contractor - Tomlinson-Kathol, Inc.

Commenced: 2/27/64
Completed: 3/9/64
Elevation: 1589 KB

<u>From</u>	<u>To</u>	<u>Description</u>	<u>Remarks</u>
0	40	Surface Hole	
40	74	Sand & Sandy Clay	
74	420	Clay & Shale	
420	533	Shale & Clay	533' 8-5/8" Surf. Csg. w/250 sacks cement
533	580	Shale	
580	1490	Shale & Shells	
1490	1640	Shale	
1640	1965	Shale & Lime	
1965	2245	Shale	
2245	2405	Shale & Lime	
2405	2610	Shale	
2540	2610	Shale & Lime	
2610	2720	Shale w/Lime	
2720	3507	Shale & Lime	
3507	3613	Lime & Shale	
3613	3705	Lime	Heebner 2961
3705		Kansas City	Brown Lime 3292
3705		Rotary Total Depth	Lansing 3303
			4 1/2" Casing 3700 - 75' net

RECEIVED
 STATE CORPORATION COMMISSION
 OCT 13 1969
 CONSERVATION DIVISION
 Wichita, Kansas

I certify to the best of my knowledge and belief, the above represents a true and accurate driller's log record of the captioned well.

Richard C. Davis

STATE OF KANSAS
 COUNTY OF SEDGWICK

Subscribed and sworn to before me this 17th day of March, 1964

Notary Public, Esther Lamone

My Commission Expires: 1/19/65