

15-095-21151-0000


STATE OF KANSAS
STATE CORPORATION COMMISSION

WELL PLUGGING RECORD

Give All Information Completely
Make Required Affidavit
Mail or Deliver Report to
Conservation Division
State Corporation Comm.
245 North Water
Wichita, KS 67202

Kingman County, Sec. 18 Twp. 28S Rge. 7 E/W
Location as "NE/CNW $\frac{1}{4}$ SW $\frac{1}{4}$ " or footage from lines
1065' FWL, 2310' FSL

Lease Owner Petroleum, Inc.
Lease Name Livingston 'E' Well No. 1
Office Address Box 1447, Great Bend, KS 67530
Character of Well (Completed as Oil, Gas or Dry Hole)

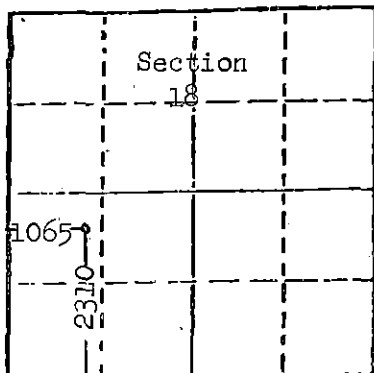

Locate well correctly on above Section Plat

Dry Hole
Date Well completed ----- 19
Application for plugging filed Sept. 22, 1981
Application for plugging approved ----- 19
Plugging commenced Sept. 14, 1981
Plugging completed Sept. 14, 1981
Reason for abandonment of well or producing formation

Rotary D & A
If a producing well is abandoned, date of last production ----- 19

Was permission obtained from the Conservation Division or its agents before plugging was commenced? ---

Name of Conservation Agent who supervised plugging of this well ---
Producing formation --- Depth to top --- Bottom --- Total Depth of Well 4045'
Show depth and thickness of all water, oil and gas formations.

OIL, GAS OR WATER RECORDS

CASING RECORD

FORMATION	CONTENT	FROM	TO	SIZE	PUT IN	PULLED OUT
Surface Hole	Sand-Redbed	Surf.	295'	8-5/8"	285'	None

Describe in detail the manner in which the well was plugged, indicating where the mud fluid was placed and the method or methods used in introducing it into the hold. If cement or other plugs were used, state the character of same and depth placed, from _____ feet to _____ feet for each plug set.


- 50 sacks 50/50 poz @ 620'
- 40 sacks 50/50 poz @ 270'
- 10 sacks 50/50 poz @ 40'
- Fill rathole w/10 sacks 50/50 poz

RECEIVED
STATE CORPORATION COMMISSION
OCT 5 1981
CONSERVATION DIVISION
Wichita, Kansas
10-5-1981

(If additional description is necessary, use BACK of this sheet)

Name of Plugging Contractor Gabbert-Jones, Inc.

STATE OF Kansas COUNTY OF Barton, ss.
Monte Chadd (employee of owner) or (owner or operator)
of the above-described well, being first duly sworn on oath, says: That I have knowledge of the facts, statements, and matters herein contained and the log of the above-described well as filed and that the same are true and correct. So help me God.

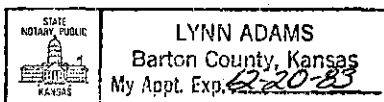

(Signature) Monte Chadd
Box 1447, Great Bend, KS 67530
(Address)

SUBSCRIBED AND SWORN TO before me this 2nd day of October, 19 81

My commission expires 12-20-83

Notary Public.

GABBERT-JONES, INC.
WICHITA, KANSAS
DRILLERS' WELL LOG

15-095-21151-0000

Livingston #1
W/2 Sec 18-285-7W
Kingman County Kansas

Commenced: 9-5-81

Completed: 9-14-81

OPERATOR: PETROLEUM INC.

Depth		Formation	Remarks
From	To		
0	295	Sand-Redbed	
295	1125	Redbed-Sand	
1125	1975	Shale	Ran 7 jts of 20# 8 5/8" csg set @ Cemented
1975	2145	Lime-Shale	w/250 sbs Common 2% Gel
2145	2390	Shale-Lime	3% CC PD @ 9:45 a.m. 9-5-81
2390	2556	Lime-Shale	
2556	3005	Shale-Lime	
3005	3120	Lime-Shale	
3120	3335	Shale-Lime	
3335	3614	Lime-Shale	
3614	3800	Shale-Lime	
3800	3910	Lime-Shale	
3910	4000	Shale-Lime	
4000	4071	Lime-Shale	DRY & ABANDONED
4071	4125	Shale-Lime	
	4125 - TD		

STATE OF KANSAS)
) SS
COUNTY OF SEDGWICK)

I, the undersigned, being duly sworn on oath, state that the above
Drillers' Well Log is true and correct to the best of my knowledge and belief, and
according to the records of this office.

RECEIVED
STATE CORPORATION COMMISSION
SEP 25 1981
CONSERVATION DIVISION
Wichita, Kansas
GABBERT-JONES, INC.
James S. Sutton II
JAMES S. SUTTON II

Subscribed and sworn to before me this 18th day of September, 1981.

Elizabeth J. Edwards
ELIZABETH J. EDWARDS-NOTARY PUBLIC

My Commission expires February 6, 1983.