

15-895-61331-0000


STATE OF KANSAS
STATE CORPORATION COMMISSION

Form CP-4

Give All Information Completely
Make Required Affidavit
Mail or Deliver Report to:
Conservation Division
State Corporation Commission
211 No. Broadway
Wichita, Kansas

WELL PLUGGING RECORD

NORTH

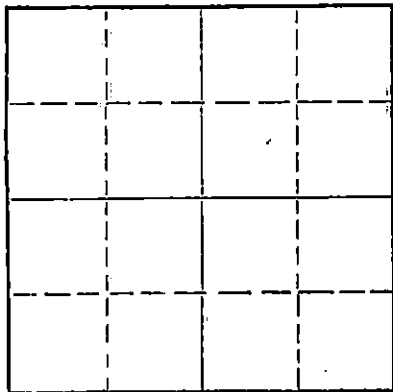

Locate well correctly on above
Section Plat

Kingman County. Sec 7 Twp. 28 Rge. (E) 7 (W)
Location as "NE/CNW/SW" or footage from lines C SE SW
Lease Owner Pickrell Drilling Company
Lease Name Bock Well No. 1
Office Address 705 4th Natl Bank Bldg, Wichita 2, Kansas
Character of Well (completed as Oil, Gas or Dry Hole) Dry Hole
Date well completed January 10, 19 64
Application for plugging filed January 10, 19 64
Application for plugging approved January 10, 19 64
Plugging commenced January 10, 19 64
Plugging completed January 10, 19 64
Reason for abandonment of well or producing formation Dry Hole

If a producing well is abandoned, date of last production 19
Was permission obtained from the Conservation Division or its agents before plugging was commenced? Yes

Name of Conservation Agent who supervised plugging of this well Fred Hampel
Producing formation Depth to top Bottom Total Depth of Well 4388 Feet
Show depth and thickness of all water, oil and gas formations.

OIL, GAS OR WATER RECORDS

CASING RECORD

FORMATION	CONTENT	FROM	TO	SIZE	PUT IN	PULLED OUT
				8 5/8	240	None

Describe in detail the manner in which the well was plugged, indicating where the mud fluid was placed and the method or methods used in introducing it into the hole. If cement or other plugs were used, state the character of same and depth placed, from feet to feet for each plug set.

Heavy mud to 260'. Set plug. Cemented with
25 sacks cement. Heavy mud to 40'. Set plug.
Cemented with 10 sacks cement to bottom of
cellar. Plugged rat hole with 2 sacks cement.

RECEIVED
STATE CORPORATION COMMISSION

JAN 29 1964

CONSERVATION DIVISION
Wichita, Kansas

(If additional description is necessary, use BACK of this sheet)

Name of Plugging Contractor Pickrell Drilling Company
Address 705 4th Natl Bank Bldg, Wichita 2, Kansas

1-29-1964

STATE OF KANSAS COUNTY OF SEDGWICK, ss.
C. W. SEBITS (owner or operator) of the above-described

well, being first duly sworn on oath, says: That I have knowledge of the facts, statements, and matters herein contained and the log of the above-described well as filed and that the same are true and correct. So help me God.

(Signature) C. W. SEBITS
705 4th Natl Bank Bldg, Wichita 2, Kansas
(Address)

SUBSCRIBED AND SWORN to before me this 13th day of January, 19 64

Maxine Blackman
Maxine Blackman Notary Public.

My commission expires June 21, 1966

ROTARY DRILLING LOG

15-095-61331-0000

COMPANY: PICKRELL DRILLING COMPANY
 705 4th National Bank Bldg
 Wichita, Kansas
 LOCATION: Bock No. 1, C SE SW Sec. 7-28-7W, Kingman County, Kansas

Rotary Drilling Commenced 12-28-63
 Rotary Drilling Completed 1-10--64

CONTRACTOR: **PICKRELL DRILLING COMPANY**
 Wichita, Kansas

CASING RECORD: (12 jts) 8 5/8" surface casing set at 240' cemented with 175 sacks cement. Circulated. Completed 12:15 A.M. December 29, 1963. No oil string run. D & A.

LOG

(Figures indicate bottom of formation — measurements from top of rotary bushing.)

30	Sand	C. F. S.
241	Red Rock	3666
1085	Red Rock & Shale	3701
1340	Shale & Lime	4000
1720	Lime	4007
2925	Lime & Shale	4012
3007	Lime	4018
3350	Lime & Shale	4028
3755	Lime	4038
3995	Lime & Shale	4145
4028	Lime	4372
4145	Mississippian	4378
4171	Mississippian Lime	4388
4270	Mississippian	
4315	Lime & Shale	
4343	Mississippian	Slope Tests
4372	Kinderhook	2500
4388	Viola & Simpson - RTD	3000
		3500
		4000

S. L. M.

3405
 3871
 4294

RECEIVED
 STATE CORPORATION COMMISSION

JAN 29 1964

CONSERVATION DIVISION
 Wichita, Kansas

The undersigned, C. W. SEBITS, Attorney-in-Fact for PICKRELL DRILLING COMPANY, hereby certifies in behalf of said Company, that the above is a true and correct log of the formation encountered in drilling the above well as reflected by the Daily Drilling Reports.

PICKRELL DRILLING COMPANY
 By: 
C. W. SEBITS Attorney-in-Fact

STATE OF KANSAS }
 COUNTY OF SEDGWICK } ss.

On this 13th day of January, 1964, before me the undersigned, a Notary Public, in and for the County and State aforesaid, personally appeared C. W. SEBITS, to me known to be the identical person who subscribed the name of PICKRELL DRILLING COMPANY to the foregoing instrument as its Attorney-in-Fact and acknowledged to me that he executed the same as his free and voluntary act and deed, and as the free and voluntary act and deed of such company, for the uses and purposes therein set forth.

Given under my hand and seal of office the day and year last above written.

My commission expires: June 21, 1966


 Maxine Blackman Notary Public