


STATE OF KANSAS  
STATE CORPORATION COMMISSION

15-095-20391-0000

WELL PLUGGING RECORD

Give All Information Completely  
Make Required Affidavit  
Mail or Deliver Report to  
Conservation Division  
State Corporation Comm.  
245 North Water  
Wichita, KS 67202

Kingman County. Sec. 35 Twp. 28S Rge. 6W E/W  
Location as "NE/CNW 1/4 SW 1/4" or footage from lines  
E/2 NE SE  
Lease Owner Graves Drilling Co., Inc  
Lease Name Fern Well No. OWWO 1  
Office Address 910 Union Center Wichita, Ks 67202  
Character of Well (Completed as Oil, Gas or Dry Hole)  
Dry Hole  
Date Well completed December 15, 1977  
Application for plugging filed December 15 1977  
Application for plugging approved December 15 1977  
Plugging commenced December 15 1977  
Plugging completed December 15 1977  
Reason for abandonment of well or producing formation

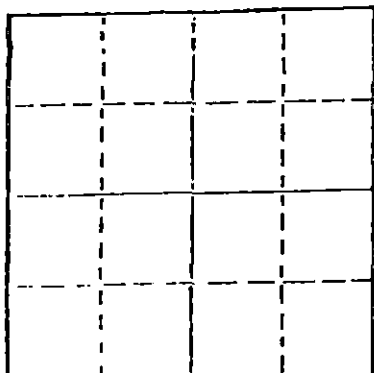

Locate well correctly on above  
Section Plot

If a producing well is abandoned, date of last production 19  
Was permission obtained from the Conservation Division or  
its agents before plugging was commenced? Yes

Name of Conservation Agent who supervised plugging of this well William T. Owen  
Producing formation Depth to top Bottom Total Depth of Well 3947  
Show depth and thickness of all water, oil and gas formations.

OIL, GAS OR WATER RECORDS

12-20-1977

CASING RECORD

FORMATION	CONTENT	FROM	TO	SIZE	PUT IN	PULLED OUT
CONSERVATION DIVISION Wichita, Kansas						

Describe in detail the manner in which the well was plugged, indicating where the mud fluid was placed and the method or methods used in introducing it into the hold. If cement or other plugs were used, state the character of same and depth placed, from feet to feet for each plug set.

Filled hole with heavy mud to 240 feet. Pumped 40 sacks of cement through drill pipe with pump truck. Pushed plug and 1/2 sack hulls to 40' and pumped 12 sacks of cement through drill pipe with pump truck to base of well cellar. Plugged rat hole with 2 sacks of cement.

(If additional description is necessary, use BACK of this sheet)

Name of Plugging Contractor Graves Drilling Co., Inc 910 Union Center

STATE OF Kansas COUNTY OF Sedgwick, ss.  
John C. Graves (employee of owner) or (owner or operator)  
of the above-described well, being first duly sworn on oath, says: That I have knowledge of the facts, statements, and matters herein contained and the log of the above-described well as filed and that the same are true and correct. So help me God.

(Signature)

910 Union Center Wichita, Kansas 67202  
(Address)

SUBSCRIBED AND SWORN TO before me this 19th day of December, 1977.

Betty Brandt  
Betty Brandt Notary Public.

My commission expires May 9, 1979