


STATE OF KANSAS  
STATE CORPORATION COMMISSION

Give All Information Completely  
Make Required Affidavit  
Mail or Deliver Report to:  
Conservation Division  
State Corporation Commission  
212 North Market, Insurance Bldg.  
Wichita, Kansas

15-095-01330-0000  
**WELL PLUGGING RECORD**

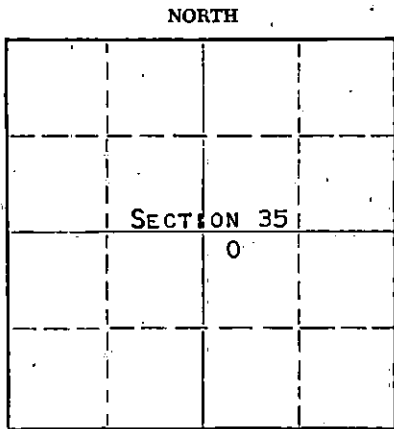

Locate well correctly on above Section Plat

KINGMAN County. Sec. 35 Twp. 28S Rge. 6W (#) (W)  
Location as "NE/CNW\*SW\*" or footage from lines NW SE NW  
Lease Owner PETROLEUM, INC.  
Lease Name KOSTNER Well No. 1  
Office Address ROUTE 2, GREAT BEND, KANSAS  
Character of Well (completed as Oil, Gas or Dry Hole) DRY HOLE  
Date well completed AUGUST 22 1960  
Application for plugging filed AUGUST 22 1960  
Application for plugging approved AUGUST 22 1960  
Plugging commenced AUGUST 22 1960  
Plugging completed AUGUST 22 1960  
Reason for abandonment of well or producing formation No PRODUCIBLE ZONES

If a producing well is abandoned, date of last production NONE 19      
Was permission obtained from the Conservation Division or its agents before plugging was commenced? YES

Name of Conservation Agent who supervised plugging of this well FRED W. HAMPEL  
Producing formation      Depth to top      Bottom      Total Depth of Well 3998 Feet  
Show depth and thickness of all water, oil and gas formations.

OIL, GAS OR WATER RECORDS

CASING RECORD

FORMATION	CONTENT	FROM	TO	SIZE	PUT IN	PULLED OUT
				8-5/8"	257'	NONE

Describe in detail the manner in which the well was plugged, indicating where the mud fluid was placed and the method or methods used in introducing it into the hole. If cement or other plugs were used, state the character of same and depth placed, from      feet to      feet for each plug set.

MUDDED UP WITH HEAVY MUD TO 240' FOLLOWED BY 1/4 SACK OF HULLS AND WOODEN PLUG. PLACED 15 SACKS CEMENT THROUGH DRILL PIPE ON TO PLUG. MUDDED UP WITH HEAVY MUD TO 35' FOLLOWED BY 1/4 SACK OF HULLS, WOODEN PLUG AND 10 SACKS CEMENT TO BASE OF WELL CELLAR.

RECEIVED  
STATE CORPORATION COMMISSION

SEP 27 1960

CONSERVATION DIVISION  
Wichita, Kansas

9-27-1960

(If additional description is necessary, use BACK of this sheet)

Name of Plugging Contractor GARVEY DRILLING COMPANY  
Address ROUTE 2, GREAT BEND, KANSAS

STATE OF KANSAS, COUNTY OF BARTON, ss.  
DON SEARLE (employee of owner) or (~~owner~~) of the above-described well, being first duly sworn on oath, says: That I have knowledge of the facts, statements, and matters herein contained and the log of the above-described well as filed and that the same are true and correct. So help me God.

(Signature) Don Searle

ROUTE 2, GREAT BEND, KANSAS  
(Address)

SUBSCRIBED AND SWORN TO before me this 23RD day of SEPTEMBER, 1960

Arthur J. Nile  
Notary Public.

My commission expires APRIL 14, 1963



# WELL LOG

15-013-01330-0000

COMPANY PETROLEUM, INCORPORATED

SEC. 35 T. 28S R. 6W

FARM KOSTNER

NO. 81

LOC. NW, SE, NW


TOTAL DEPTH 3998'

COUNTY KINGMAN CO., KANSAS

COMM. August 10, 1960

COMP. August 22, 1960

CONTRACTOR GARVEY DRILLING COMPANY

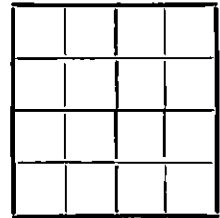

CASING 8 5/8" @ 257' w/175 szx.

ELEVATION 1473' DF

PRODUCTION D & A

FIGURES INDICATE BOTTOM OF FORMATIONS

160	Lime, shale & red rock
215	Red rock
257	Anhydrite & blue shale
880	Shale
1280	Shale, shells & lime
1615	Lime
2817	Shale & lime
2979	Shale
3115	Shale & lime
3854	Lime
3924	Lime & shale
3998	Mississippi lime
3998	T. D.

RECEIVED  
STATE CORPORATION COMMISSION  
SEP 27 1960  
CONSERVATION DIVISION  
Wichita, Kansas

State of KANSAS }  
County of BARTON } ss.

I, VERNE A. MORRIS of GARVEY DRILLING COMPANY

upon oath state that the above and foregoing is a true and correct copy of the log of the #2 KOSTNER well

Verne A. Morris

Subscribed and sworn to before me this 22nd day of September 19 60

My Commission Expires: April 14, 1963

Arthur J. Wiles  
NOTARY PUBLIC