


STATE OF KANSAS  
STATE CORPORATION COMMISSION

Form CP-4

Give All Information Completely  
Make Required Affidavit  
Mail or Deliver Report to:  
Conservation Division  
State Corporation Commission  
212 No. Market  
Wichita, Kansas 67202

WELL PLUGGING RECORD

NORTH

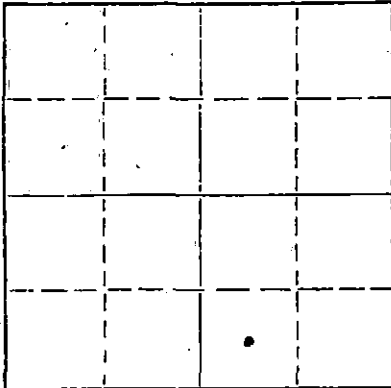

Locate well correctly on above  
Section Plat

Kiowa County. Sec. 32 Twp. 29 Rge. (E) 18 (W)  
Location as "NE/CNW/SW" or footage from lines G SW SE  
Lease Owner Misco Supply Company  
Lease Name Parkin "A" Well No. 2  
Office Address 257 N. Broadway, Wichita, Kansas  
Character of Well (completed as Oil, Gas or Dry Hole) oil  
Date well completed \_\_\_\_\_ 19\_\_\_\_  
Application for plugging filed July 28 19 71  
Application for plugging approved \_\_\_\_\_ 19\_\_\_\_  
Plugging commenced August 6 19 71  
Plugging completed August 12 19 71  
Reason for abandonment of well or producing formation depleted

If a producing well is abandoned, date of last production \_\_\_\_\_ 19\_\_\_\_  
Was permission obtained from the Conservation Division or its agents before plugging was commenced? yes

Name of Conservation Agent who supervised plugging of this well G. R. Biberstein  
Producing formation \_\_\_\_\_ Depth to top \_\_\_\_\_ Bottom \_\_\_\_\_ Total Depth of Well 4965 Feet  
Show depth and thickness of all water, oil and gas formations.

OIL, GAS OR WATER RECORDS

CASING RECORD

FORMATION	CONTENT	FROM	TO	SIZE	PUT IN	PULLED OUT
		0	375'	8 5/8"	375'	none
		0	4952'	5 1/2"	4952'	2918.60

Describe in detail the manner in which the well was plugged, indicating where the mud fluid was placed and the method or methods used in introducing it into the hole. If cement or other plugs were used, state the character of same and depth placed, from \_\_\_\_\_ feet to \_\_\_\_\_ feet for each plug set.

Sanded back to 4900' and dumped 5 sacks of cement.  
Set 20' rock bridge at 260'. Plugged well with 4 yards of ready mix cement.

RECEIVED  
STATE CORPORATION COMMISSION  
SEP 3 1971  
CONSERVATION DIVISION  
Wichita, Kansas

Name of Plugging Contractor PIPE PULLERS, INC.  
Address Box 486, Ellinwood, Kansas

STATE OF KANSAS COUNTY OF BARTON, ss.  
Evelyn Roth (employee of owner) or (owner or operator) of the above-described well, being first duly sworn on oath, says: That I have knowledge of the facts, statements, and matters herein contained and the log of the above-described well as filed and that the same are true and correct. So help me God.

(Signature) Evelyn Roth  
Ellinwood, Kansas  
(Address)

SUBSCRIBED AND SWORN TO before me this 1 day of September 1971

My commission expires Feb. 10, 1975

George A. Meyer  
Notary Public.

WELL LOG BUREAU—KANSAS GEOLOGICAL SOCIETY  
508 East Murdock, Wichita, Kansas


COPY

Company- NORTHERN NATURAL GAS  
Farm- Parkin "A" No2

SEC. 32 T. 29 R. 18W  
C SW SE

Total Depth. 4965'  
Comm. 8-16-58 Comp. 9-6-58  
Shot or Treated.  
Contractor. Capitt Drig.  
Issued. 3-14-59

County Kiowa KANSAS

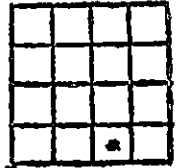

Elevation. 2178' RB

Production. 21 BOPD

CASING:

8" 375' cem w/225 sx.  
5 1/2" 4952' cem w/20 sx.

Figures Indicate Bottom of Formations.

clay	15
shale, sand	80
sand, shale	330
shale	380
red bed, lime strks	625
red bed, lime strks	1055
red bed, lime strks	1110
shale, shells	1750
shale, lime strks	1930
shale, lime shells	2175
shale, lime	2430
lime	2627
shale, lime	2735
lime	2906
lime, shale	3023
lime, shale breaks	3151
lime, shale	3240
shale, lime	3410
lime	3594
lime, shale	3876
lime	4055
lime, shale	4270
lime	4965

Total Depth

TOPS: SCOUT

Heebner	4087
Toronto	4101
Douglas	4120
Lansing	4278
Mississippi	4875

RECEIVED  
STATE CORPORATION COMMISSION  
JUL 29 1971  
CONSERVATION DIVISION  
Wichita, Kansas