


STATE OF KANSAS
STATE CORPORATION COMMISSION

Form CP-4

Give All Information Completely
Make Required Affidavit
Mail or Deliver Report to:
Conservation Division
State Corporation Commission
212 No. Market
Wichita, Kansas 67202

WELL PLUGGING RECORD

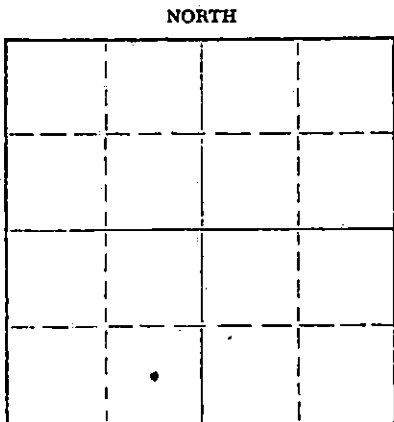

Locate well correctly on above
Section Plat

Kiowa County, Sec. 32 Twp. 29 Rge. (E) 18 (W)

Location as "NE/CNW/SW" or footage from lines C SE SW
Lease Owner Misco Supply Company
Lease Name Parkin "A" Well No. 3
Office Address 257 N. Broadway, Wichita, Kansas
Character of Well (completed as Oil, Gas or Dry Hole) oil
Date well completed _____ 19____
Application for plugging filed July 28 1971
Application for plugging approved _____ 19____
Plugging commenced August 11 1971
Plugging completed August 21 1971
Reason for abandonment of well or producing formation depleted

If a producing well is abandoned, date of last production _____ 19____
Was permission obtained from the Conservation Division or its agents before plugging was commenced? yes

Name of Conservation Agent who supervised plugging of this well G. R. Biberstein
Producing formation _____ Depth to top _____ Bottom _____ Total Depth of Well 4990 Feet
Show depth and thickness of all water, oil and gas formations.

OIL, GAS OR WATER RECORDS

CASING RECORD

FORMATION	CONTENT	FROM	TO	SIZE	PUT IN	PULLED OUT
		0	385'	8 5/8"	385'	none
		0	4985'	5 1/2"	4985'	2850.25

Describe in detail the manner in which the well was plugged, indicating where the mud fluid was placed and the method or methods used in introducing it into the hole. If cement or other plugs were used, state the character of same and depth placed, from _____ feet to _____ feet for each plug set.

Sanded back to 4900' and dumped 5 sacks of cement.

Set 20' rock bridge at 260'. Plugged well with 4 yards of ready mix cement.

RECEIVED
STATE CORPORATION COMMISSION
SEP 15 1971
CONSERVATION DIVISION
Wichita, Kansas

Name of Plugging Contractor PIPE PULLERS, INC.
Address Box 486, Ellinwood, Kansas

STATE OF KANSAS, COUNTY OF BARTON, ss.
Evelyn Roth (employee of owner) or (owner or operator) of the above-described well, being first duly sworn on oath, says: That I have knowledge of the facts, statements, and matters herein contained and the log of the above-described well as filed and that the same are true and correct. So help me God.

(Signature) Evelyn Roth
Ellinwood, Kansas
(Address)

SUBSCRIBED AND SWORN TO before me this 14th day of September, 1971

George A Meyer
Notary Public.

My commission expires Feb. 10, 1975

WELL LOG BUREAU--KANSAS GEOLOGICAL SOCIETY
508 East Murdock, Wichita, Kansas

15-097-10127-0000


COPY

Company- NORTHERN NATURAL GAS PRODUCING CO.
Farm- Parkin "A" No. 3

SEC. 32 T. 29 R. 18W
C SE SW

Total Depth. 4990'
Comm. 11-22-58 Comp. 12-10-58
Shot or Treated.
Contractor. Capitt Drlg.
Issued. 10-3-59

County Kiowa
KANSAS

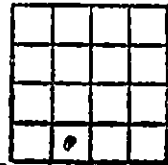

Elevation. 2211' RB

Production. 223 BOPD

CASING:

8 5/8" 385' cem w/275 sx.
5 1/2" 4985' cem w/130 sx.

Figures Indicate Bottom of Formations.

soil & clay	75
shale & shells	245
shale & lime	389
red bed & shale	875
shale & lime	1705
shale & shells	1920
shale & lime	2356
lime & shale	2455
lime	2536
lime & shale	2640
lime	2965
shale & lime	3125
lime & shale	3351
shale & lime	3489
lime & shale	3693
shale & lime	3849
lime	4117
shale & lime	4298
lime	4990 RTD
Total Depth	

TOPS: SCOUT	
Heebner	4118
Lansing	4314
Cherokee	4837
Mississippi	4916

RECEIVED
STATE CORPORATION COMMISSION
JUL 29 1971
CONSERVATION DIVISION
Wichita, Kansas