


STATE OF KANSAS, STATE CORPORATION COMMISSION

WELL PLUGGING RECORD

Give All Information Completely Make Required Affidavit Mail or Deliver Report to: Conservation Division State Corporation Commission 800 Bittling Building Wichita, Kansas

Kiowa County. Sec. 21 Twp. 29S Rge. 18 (W)

Location as "NE/CNW 1/4 SW 1/4" or footage from lines Center NE SE Lease Owner Gulf Oil Corporation Lease Name F. Thorn Well No. 4 Office Address Box 661, Tulsa, Oklahoma Character of Well (completed as Oil, Gas or Dry Hole) Dry hole Date well completed 11-19 19 56 Application for plugging filed 11-19 19 56 Application for plugging approved 11-19 19 56 Plugging commenced 11-20 19 56 Plugging completed 11-20 19 56 Reason for abandonment of well or producing formation Dry hole

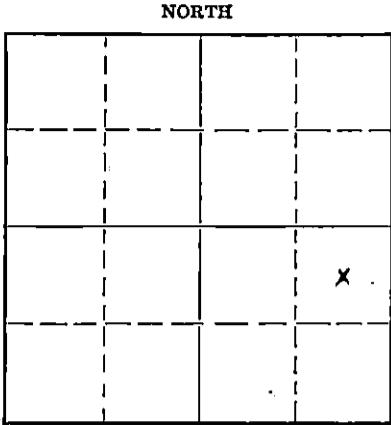

Locate well correctly on above Section Flat

If a producing well is abandoned, date of last production Dry hole 19 Was permission obtained from the Conservation Division or its agents before plugging was commenced? Yes

Name of Conservation Agent who supervised plugging of this well M. A. Rives Producing formation Depth to top Bottom Total Depth of Well 5000 Feet Show depth and thickness of all water, oil and gas formations.

OIL, GAS OR WATER RECORDS

CASING RECORD

Table with 7 columns: Formation, Content, From, To, Size, Put In, Pulled Out. Row 1: 8-5/8", 361.5', - 0 -

Describe in detail the manner in which the well was plugged, indicating where the mud fluid was placed and the method or methods used in introducing it into the hole. If cement or other plugs were used, state the character of same and depth placed, from feet to feet for each plug set.

Spotted 25 sacks regular cement thru open-end drill pipe at 1990'. Filled with mud to 250'. Pushed HOWCO plug to 250' and spotted 20 sacks regular cement on top of plug. Filled with mud to 35' and placed HOWCO plug at 35'. Dumped 1/4 sack cottonseed hulls on plug and filled to bottom of cellar with cement.

Note: Attached is Formation Record which is being sent in accordance with your instructions.

RECEIVED STATE CORPORATION COMMISSION DEC 1 - 1956 CONSERVATION DIVISION Wichita, Kansas 12-1-1956

(If additional description is necessary, use BACK of this sheet)

Correspondence regarding this well should be addressed to L. L. Gray Address Box 2233, Wichita, Kansas

STATE OF Kansas, COUNTY OF Sedgwick, ss. T. A. Trax (employee of owner) of the above-described well, being first duly sworn on oath, says: That I have knowledge of the facts, statements, and matters herein contained and the log of the above-described well as filed and that the same are true and correct. So help me God.

(Signature) T. A. Trax

Box 2233, Wichita, Kansas (Address)

SUBSCRIBED AND SWORN to before me this 28th day of November, 19 56

Ray W. Rouser Notary Public.

My commission expires 2-1-59

PLUGGING FILE SEC 21 T 29 R 18 W1 BOCK PAGE 118 LINE 24

WELL LOG

COMPANY: GULF OIL CORPORATION

FARM: Faythorn No. 4

TOTAL DEPTH - 5,000'

COMM: 10-31-56. COMP: 11-20-56.

SEC. 21-298-18W

LOC. NE SE

COUNTY - Kiowa

CASING

8-5/8" - 375'

ELEVATION

D.F. -

Gr. -

DRILLER'S LOG

Shale & Red Bed	0	756
Red Bed & Shells	756	1504
Red Bed, Shale & Shells	1504	1865
Red Bed & Shells	1865	2327
Shale & Lime	2327	2465
Lime	2465	2547
Lime & Shale	2547	2759
Lime	2759	2839
Shale & Lime	2839	3288
Shale	3288	3736
Shale & Shells	3736	3773
Shale & Lime	3773	3986
Lime	3986	4153
Shale	4153	4300
Lime	4300	4309
Lime & Shale	4309	4405
Lime	4405	4808
Shale & Lime	4808	4849
Lime	4849	4914
Lime & Chert	4914	4970
Lime	4970	5000
Total Depth		5000

RECEIVED  
STATE COMMISSION

CONSERVATION  
Kiowa, Ko

MINING  
SEC 21 T 29 R 18W  
BOOK PAGE 118 LINE 24