


STATE OF KANSAS
STATE CORPORATION COMMISSION

Form CP-4

WELL PLUGGING RECORD

Give All Information Completely
Make Required Affidavit
Mail or Deliver Report to:
Conservation Division
State Corporation Commission
212 No. Market
Wichita, Kansas 67202

NORTH

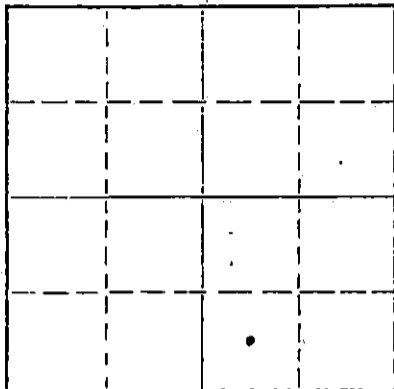

Locate well correctly on above
Section Plot

Kiowa County. Sec. 21 Twp. 29 Rge. (E) 18 (W)
Location as "NE/CNW/SE" or footage from lines. C SW SE
Lease Owner Misco Supply Company
Lease Name Fay Thorn Well No. 1
Office Address 257 N. Broadway, Wichita, Kansas.
Character of Well (completed as Oil, Gas or Dry Hole) oil
Date well completed 19__
Application for plugging filed June 15 1971
Application for plugging approved 19__
Plugging commenced October 7 1971
Plugging completed November 5 1971
Reason for abandonment of well or producing formation depleted

If a producing well is abandoned, date of last production 19__

Was permission obtained from the Conservation Division or its agents before plugging was commenced? yes

Name of Conservation Agent who supervised plugging of this well G. R. Biberstein

Producing formation _____ Depth to top _____ Bottom _____ Total Depth of Well 5095 Feet

Show depth and thickness of all water, oil and gas formations.

OIL, GAS OR WATER RECORDS

CASING RECORD

FORMATION	CONTENT	FROM	TO	SIZE	PUT IN	PULLED OUT
		0	376'	8 5/8"	376'	none
		0	5094'	5 1/2"	5094'	2706.95

Describe in detail the manner in which the well was plugged, indicating where the mud fluid was placed and the method or methods used in introducing it into the hole. If cement or other plugs were used, state the character of same and depth placed, from _____ feet to _____ feet for each plug set.

Sanded back to 5000' and dumped 5 sacks of cement.
Set 20' rock bridge at 260'. Plugged well with 4 yards of ready mix cement.

RECEIVED
STATE CORPORATION COMMISSION
NOV 12 1971
CONSERVATION DIVISION
Wichita, Kansas

(If additional description is necessary, use BACK of this sheet)
Name of Plugging Contractor PIPE PULLERS, INC.
Address Box 486, Ellinwood, Kansas 67526

STATE OF KANSAS, COUNTY OF BARTON, ss.
Evelyn Roth (employee of owner) or (owner or operator) of the above-described

well, being first duly sworn on oath, says: That I have knowledge of the facts, statements, and matters herein contained and the log of the above-described well as filed and that the same are true and correct. So help me God.

(Signature) Evelyn Roth
Ellinwood, Kansas (Address)

SUBSCRIBED AND SWORN TO before me this 11th day of November, 1971

My commission expires Feb. 10, 1975
Seague A Meyer Notary Public.

WELL LOG BUREAU—KANSAS GEOLOGICAL SOCIETY
508 East Murdock,
Wichita, Kansas

15-097-10081-2000


COPY *RP*

Company- GULF OIL CORP. ET AL
Farm- Fay Thorn No. 1

SEC. 21 T. 29 R. 18W
C SW SE
705' E WL 660' N SL SE

Total Depth. 5095' PB 5050'
Comm. 7-22-56 Comp. 8-15-56
Shot or Treated.
Contractor.
Issued. 10-27-56

County: Kiowa
KANSAS

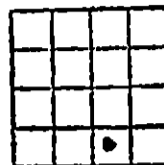

Elevation. 2247.1 DF

Production. Pot. 2735 BOPD

CASING:

8 5/8" 376'
5 1/2" 5094'

Figures Indicate Bottom of Formations.

surface soil-sand-shale	265
red bed-shells	636
shale	1045
shale-shells	1552
shale	1956
shale-shells	2391
lime-shale	3100
shale	3623
lime-shale	3721
shale	3728
lime	4113
shale	4122
shale-lime	4253
shale	4320
lime	4504
lime-shale	4597
lime	4660
lime-shale	4940
lime	4972
chert	4996
lime	5016
chert	5029
lime	5036
lime-chert	5077
lime-shale	5095
Total Depth	PB 5050

TOPS:	SAMPLE	SCHL.
Heebner shale	4147	4150
Douglas Group	4180	4182
Brown lime	4320	4324
Lansing-Kansas City	4334	4342
Mississippian chert	4937	4940
Mississippian lime	5036	5036

Perf. fr 5000-5010' w/4 shots.
Treated w/250 gals. mud acid.

Sand Record-
Miss. chert (Perf. 5000-5010')

Schlumberger T.D. 5096

I.P. Oil "F" 66.24 bbls in 3 hrs.
Indicated maximum capacity 3000 BO.

RECEIVED
STATE CORPORATION COMMISSION
JUN 17 1971
CONSERVATION DIVISION
Wichita, Kansas