


STATE OF KANSAS
STATE CORPORATION COMMISSION

Form CP-4

WELL PLUGGING RECORD

Give All Information Completely
Make Required Affidavit.
Mail or Deliver Report to:
Conservation Division
State Corporation Commission
212 No. Market
Wichita, Kansas 67202

NORTH

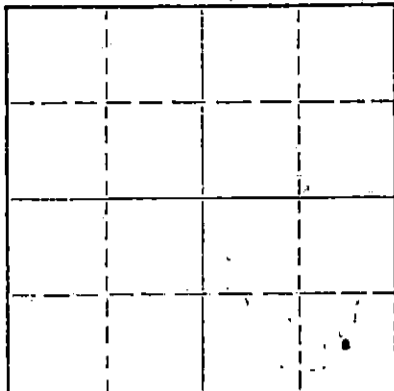

Locate well correctly on above
Section Plat

Kiowa County. Sec. 21 Twp. 29 Rge. 18 (E) 18 (W)
Location as "NE/CNWxSWx" or footage from lines C SE SE
Lease Owner Misco Supply Company
Lease Name Fay Thorn Well No. 2
Office Address 257 N. Broadway, Wichita, Kansas
Character of Well (completed as Oil, Gas or Dry Hole) oil
Date well completed _____ 19____
Application for plugging filed June 15 1971
Application for plugging approved _____ 19____
Plugging commenced October 14 1971
Plugging completed November 5 1971
Reason for abandonment of well or producing formation depleted

If a producing well is abandoned, date of last production _____ 19____
Was permission obtained from the Conservation Division or its agents before plugging was commenced? yes

Name of Conservation Agent who supervised plugging of this well G. R. Biberstein
Producing formation _____ Depth to top _____ Bottom _____ Total Depth of Well 5100 Feet
Show depth and thickness of all water, oil and gas formations.

OIL, GAS OR WATER RECORDS

CASING RECORD

FORMATION	CONTENT	FROM	TO	SIZE	PUT IN	PULLED OUT
		0	368'	8 5/8"	368'	none
		0	5099'	5 1/2"	5099'	3446.96

Describe in detail the manner in which the well was plugged, indicating where the mud fluid was placed and the method or methods used in introducing it into the hole. If cement or other plugs were used, state the character of same and depth placed, from _____ feet to _____ feet for each plug set.

Sanded back to 5000' and dumped 5 sacks of cement.
Set 20' rock bridge at 260'. Plugged well with 4 yards of ready mix cement.

RECEIVED
STATE CORPORATION COMMISSION
NOV 12 1971
CONSERVATION DIVISION
Wichita, Kansas

11-17-1971

Name of Plugging Contractor PIPE PULLERS, INC.
Address Box 486, Ellinwood, Kansas 67526

STATE OF KANSAS, COUNTY OF BARTON, ss.
Evelyn Roth (employee of owner) or (owner or operator) of the above-described well, being first duly sworn on oath, says: That I have knowledge of the facts, statements, and matters herein contained and the log of the above-described well as filed and that the same are true and correct. So help me God.

(Signature) Evelyn Roth
Ellinwood, Kansas (Address)

SUBSCRIBED AND SWORN TO before me this 11th day of November, 19 71
George A Meyer Notary Public.

My commission expires Feb. 10, 1975

WELL LOG BUREAU—KANSAS GEOLOGICAL SOCIETY
508 East Murdock, Wichita, Kansas


15-097-10080-0000
COPY *DR*

Company- GULF OIL CORP.
Farm- Fay Thorn No. 2

SEC. 21 T. 29 R. 18W
C SE SE

Total Depth. 5100'
Comm. 10-9-56 Comp. 10-25-56
Shot or Treated.
Contractor.
Issued. 12-15-56

County Kiowa
KANSAS

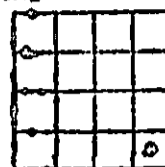

Elevation. 2236' DF

Production. 1537 BOPD

Figures indicate Bottom of Formations.

clay	40
sand-shale	369
shale-red bed	1965
shale	2274
shale-lime	2444
lime	3084
lime-shale	3717
lime	4031
lime-shale	4169
shale	4304
shale-lime	4716
lime	4918
lime-chert-shale	5000
chert-lime	5097
lime	5100
Total Depth	

TOPS:Heebner shale	4133
Douglas Group	4164
Brown lime	4304
Lansing-Kansas City	4314
Mississippian chert	4935
lime (scout)	5020

RECEIVED
STATE CORPORATION COMMISSION
JUN 17 1971
CONSERVATION DIVISION
Wichita, Kansas

RECEIVED
STATE CORPORATION COMMISSION
JUN 17 1971
CONSERVATION DIVISION
Wichita, Kansas