


STATE OF KANSAS
STATE CORPORATION COMMISSION

Give All Information Completely
Make Required Affidavit
Mail or Deliver Report to
Conservation Division
State Corporation Commission
245 North Water
Wichita, KS 67202

FORM CP-4

WELL PLUGGING RECORD

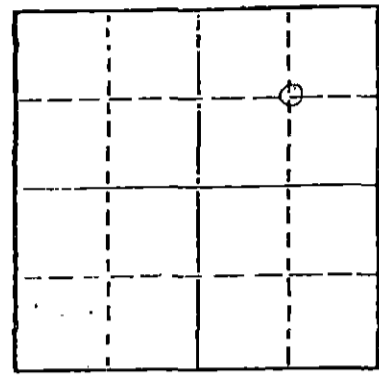

Locate well correctly on above
Section Plot

GRAY County. Sec. 4 Twp. 29 Rge. 28 (E) (W)
Location as "NE/CNW/SW" or footage from lines Center NE
Lease Owner B.M.G., INC.
Lease Name FLAIR Well No. 1
Office Address 1400 Metrobank Bldg., Denver, Co. 80202
Character of Well (completed as Oil, Gas or Dry Hole) Dry Hole
Date well completed Feb. 3 1976
Application for plugging filed 19
Application for plugging approved Feb. 9 1976
Plugging commenced Feb. 4 1976
Plugging completed Feb. 4 1976
Reason for abandonment of well or producing formation DRY HOLE

If a producing well is abandoned, date of last production 19
Was permission obtained from the Conservation Division or its agents before plugging was commenced? Yes

Name of Conservation Agent who supervised plugging of this well Clarence Thomas
Producing formation _____ Depth to top _____ Bottom _____ Total Depth of Well _____ Feet
Show depth and thickness of all water, oil and gas formations.

OIL, GAS OR WATER RECORDS

CASING RECORD

FORMATION	CONTENT	FROM	TO	SIZE	PUT IN	PULLED OUT
		0	390	8-5/8	390	NONE

Describe in detail the manner in which the well was plugged, indicating where the mud fluid was placed and the method or methods used in introducing it into the hole. If cement or other plugs were used, state the character of same and depth placed, from _____ feet to _____ feet for each plug set.

45 sx. 900'	RECEIVED STATE CORPORATION COMMISSION MAR 07 1976 CONSERVATION DIVISION Wichita, Kansas
35 sx. 390'	
15 sx. 40-0'	
5 sx. Mouse Hole	
5 sx. Rat Hole	

3-1-1976

(If additional description is necessary, use BACK of this sheet)

Name of Plugging Contractor B&N DRILLING
Address P.O. Box 846, Independence, Kansas 67301

STATE OF COLORADO COUNTY OF DENVER ss.
JAMES JAMESON (employee of owner) or (owner or operator) of the above-described

well, being first duly sworn on oath, says: That I have knowledge of the facts, statements, and matters herein contained and the log of the above-described well as filed and that the same are true and correct. So help me God.

(Signature) James Jameson
1400 Metrobank Bldg., Denver, Co. 80202
(Address)

SUBSCRIBED AND SWORN TO before me this 26 day of February 1976

My commission expires December 18, 1978

Geraldine Lancia
Notary Public.

KANSAS DRILLERS LOG

S. 4 T. 29 R. 28 ^{Ex} _W

API No. 15 — Gray County — Number

Loc. Center NE $\frac{1}{4}$

County Gray

Operator
BMG, INC.

Address
1400 Metro Bank Bldg., 475 17th St., Denver, CO 80202


Well No. 1 Lease Name Flair

Footage Location
feet from (N) (S) line feet from (E) (W) line

Principal Contractor B & N Drilling Company Geologist

Spud Date 1/27/76 Total Depth 3266' P.B.T.D.

Date Completed 2/05/76 Oil Purchaser

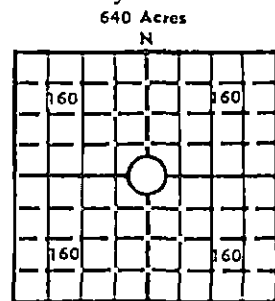

Locate well correctly
Elev.: Gr.

DF KB

CASING RECORD

Report of all strings set — surface, intermediate, production, etc.

Purpose of string	Size hole drilled	Size casing set (in O.D.)	Weight lbs/ft.	Setting depth	Type cement	Socks	Type and percent additives
Surface	12 $\frac{1}{2}$ "	8 5/8"					

LINER RECORD

PERFORATION RECORD

Top, ft.	Bottom, ft.	Sacks cement	Shots per ft.	Size & type	Depth interval

TUBING RECORD

Size	Setting depth	Packer set at

ACID, FRACTURE, SHOT, CEMENT SQUEEZE RECORD

Amount and kind of material used	Depth interval treated

INITIAL PRODUCTION

Date of first production <u> </u>	Producing method (flowing, pumping, gas lift, etc.) <u> </u>
RATE OF PRODUCTION PER 24 HOURS	Oil <u> </u> bbls. Gas <u> </u> MCF Water <u> </u> bbls. Gas-oil ratio <u> </u> CFPB
Disposition of gas (vented, used on lease or sold) <u> </u>	Producing interval (s) <u> </u>

INSTRUCTIONS: As provided in KCC Rule 82-2-125, within 90 days after completion of a well, one completed copy of this Drillers Log shall be transmitted to the State Geological Survey of Kansas, 4150 Monroe Street, Wichita, Kansas 67209. Copies of this form are available from the Conservation Division, State Corporation Commission, 3830 So. Meridian (P.O. Box 17027), Wichita, Kansas 66217. Phone AC 316-522-2206. If confidential custody is desired, please note Rule 82-2-125. Drillers Logs will be on open file in the Oil and Gas Division, State Geological Survey of Kansas, Lawrence, Kansas 66044.

Operator

DESIGNATE TYPE OF COMP.: OIL, GAS, DRY HOLE, SWDW, ETC.:

BMG, INC.

Well No.

Lease Name

1

Flair

S 4 T 29 R 28 W

WELL LOG

Show all important zones of porosity and contents thereof; cored intervals, and all drill-stem tests, including depth interval tested, cushion used, time tool open, flowing and shut-in pressures, and recoveries.

SHOW GEOLOGICAL MARKERS, LOGS RUN, OR OTHER DESCRIPTIVE INFORMATION.

FORMATION DESCRIPTION, CONTENTS, ETC.	TOP	BOTTOM	NAME	DEPTH
soil/clay/sand/shale	0	410		
shale/red bed	410	1375		
shale	1375	2425		
lime	2425	2582		
shale/lime	2582	2734		
lime	2734	2790		
lime/shale	2790	2845		
lime	2845	3266		

RECEIVED
 STATE GEOLOGICAL COMMISSION
 MAY 13 1970
 CONSERVATION DIVISION
 Wichita, Kansas

USE ADDITIONAL SHEETS, IF NECESSARY, TO COMPLETE WELL RECORD.

Date Received

Signature

Title

Date