


STATE OF KANSAS
STATE CORPORATION COMMISSION

WELL PLUGGING RECORD

Give All Information Completely
Make Required Affidavit
Mail or Deliver Report to:
Conservation Division
State Corporation Commission
800 Bittling Building
Wichita, Kansas

Ford County. Sec. 23 Twp. 29 Rge. 26 (E) (W)
Location as "NE/CNW $\frac{1}{4}$ SW $\frac{1}{4}$ " or footage from lines 330 ft.
Lease Owner L. W. Seigel S. A. Berwick Drilling Co.
Lease Name Lutz Well No. 1
Office Address Great Bend, Kansas
Character of Well (completed as Oil, Gas or Dry Hole) Dry
Date well completed 8-2-52 19
Application for plugging filed 8-2-52 19
Application for plugging approved Yes 19
Plugging commenced 8-2-52 19
Plugging completed 8-2-52 19
Reason for abandonment of well or producing formation Dry
If a producing well is abandoned, date of last production 19
Was permission obtained from the Conservation Division, or its agents before plugging was commenced? Yes

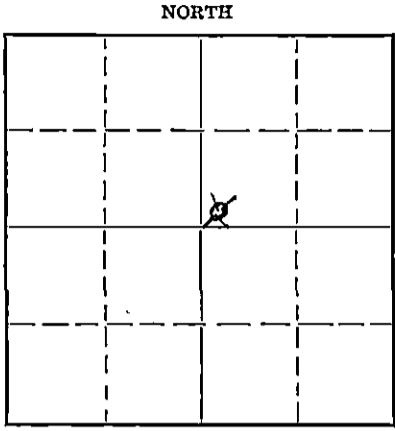

Locate well correctly on above Section Plat

Name of Conservation Agent who supervised plugging of this well Marla Rieves
Producing formation None Depth to top - Bottom - Total Depth of Well 5105 Feet
Show depth and thickness of all water, oil and gas formations.

OIL, GAS OR WATER RECORDS

CASING RECORD

Formation	Content	From	To	Size	Put In	Pulled Out

Describe in detail the manner in which the well was plugged, indicating where the mud fluid was placed and the method or methods used in introducing it into the hole. If cement or other plugs were used, state the character of same and depth placed, from 35 feet to 35 feet for each plug set.

Filled hole with heavy mud. Bridged hole at 210 ft. and cemented with 20 sacks.
Bridged hole at 35 ft. and cemented with 15 sacks to top.

8-7-52

STATE CORPORATION COMMISSION
CONSERVATION DIVISION
WICHITA, KANSAS


(If additional description is necessary, use BACK of this sheet)
Correspondence regarding this well should be addressed to S. A. Berwick Drilling Co.
Address Box 64, Great Bend, Kansas

STATE OF Kansas, COUNTY OF Barton, ss.
S. A. Berwick (employee of owner) or (owner or operator) of the above-described well,
being first duly sworn on oath, says: That I have knowledge of the facts, statements, and matters herein contained and the log of the above-described well as filed and that the same are true and correct. So help me God.

(Signature) S. A. Berwick
Box 64 Great Bend, Ks.
(Address)

SUBSCRIBED AND SWORN to before me this 6th day of August, 1952
Clayton Bell Notary Public.

My commission expires Feb 16, 1955

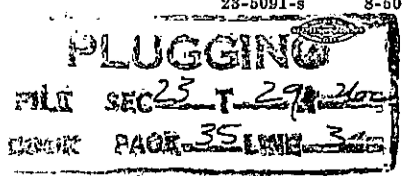

I. W. SEIGEL & S. A. BERWICK DRILLING CO.
P. O. Box 64
Great Bend, Kansas

Lutz No. 1, SW - SW - NE - 23-29S-26W, Ford County, Kansas

Commenced: 7- 7-52
Completed: 8- 2-52
Total Depth: 5105'

Elevation: 2534 D. F.
Contractor: S. A. Berwick Drlg. Co.

Strata	Depth
Surface Soil, Sand, and Shale	0 - 217
Shale and Shells	217 - 950
Red Bed and Shale	950 - 1080
Shale and Red Bed	1080 - 1480
Anhydrite	1480 - 1500
Shale and Shells	1500 - 2305
Lime and Shale	2305 - 2960
Lime	2960 - 3000
Lime and Shale	3000 - 3295
Lime	3295 - 3355
Lime and Shale	3355 - 3965
Lime	3965 - 4175
Lime and Shale	4175 - 4250
Lime	4250 - 4300
Lime and Shale	4300 - 4335
Lime	4335 - 4400
Lime and Shale	4400 - 4425
Lime	4425 - 5105

I hereby certify the above a true and correct log as reflected by the Daily Drilling Reports of the S. A. Berwick Drilling Co.

By: S. A. Berwick
S. A. Berwick, Owner

Signed and sworn to in my presence this 6 th day of August, 1952,
by S. A. Berwick, Owner of the S. A. Berwick Drilling Co.

Clayton Bell

Notary Public

My Commission Expires: Feb 16, 1955

