


Give All Information Completely
Make Required Affidavit
Mail or Deliver Report to:
Conservation Division
State Corporation Commission
211 No. Broadway
Wichita, Kansas

WELL PLUGGING RECORD

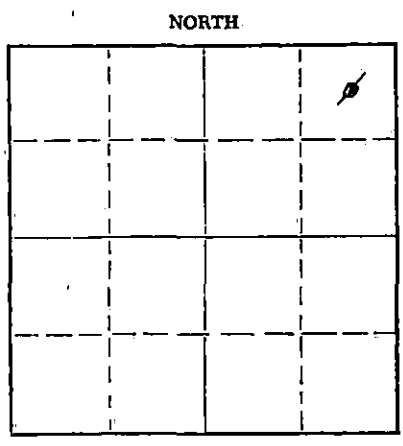

Gray County. Sec. 6 Twp. 29S Rge. (E) 30(W)
Location as "NE/CNW&SW" or footage from lines 660' WEL and 660' SNL
Lease Owner Gulf Oil Corporation
Lease Name Harry J. Bunnell Well No. 1
Office Address 316 Union Center Building, Wichita, Kansas 67202
Character of Well (completed as Oil, Gas or Dry Hole) Dry Hole
Date well completed December 15 19 63
Application for plugging filed December 16 19 63
Application for plugging approved Orally December 15 19 63
Plugging commenced December 15 19 63
Plugging completed December 15 19 63
Reason for abandonment of well or producing formation

If a producing well is abandoned, date of last production 19
Was permission obtained from the Conservation Division or its agents before plugging was commenced? Yes

Name of Conservation Agent who supervised plugging of this well Archie Elving
Producing formation Depth to top Bottom Total Depth of Well 5503 Feet
Show depth and thickness of all water, oil and gas formations.

OIL, GAS OR WATER RECORDS

CASING RECORD

FORMATION	CONTENT	FROM	TO	SIZE	PUT IN	PULLED OUT
				8-5/8"	1740.80'	NONE

Describe in detail the manner in which the well was plugged, indicating where the mud fluid was placed and the method or methods used in introducing it into the hole. If cement or other plugs were used, state the character of same and depth placed, from feet to feet for each plug set.

Ran open-end DP to 5495'. Cemented w/20 sks reg cmt at 5495'. Cmt plug from 5425-95'. Pulled up to 1600' and cemented w/26 sx reg. cmt. Cmt plug 1514-1600'. Pulled up to 40' and set 10 sx reg cmt. Cmt. plug 8'-40'. Cut off 8-5/8" csg 2' below ground level and capped with steel plate. Cmt at surface w/2 sx reg cmt. in mouse hole.

RECEIVED
STATE CORPORATION COMMISSION

DEC 18 1963

12-18-1963

CONSERVATION DIVISION
Wichita, Kansas

(If additional description is necessary, use BACK of this sheet)
Name of Plugging Contractor R. W. Rine Drilling, Inc.
Address 420 Union Center Building, Wichita, Kansas 67202

STATE OF KANSAS, COUNTY OF SEDGWICK, ss.
G. V. Kersten (employee of owner) or (owner or operator) of the above-described well; being first duly sworn on oath, says: That I have knowledge of the facts, statements, and matters herein contained and the log of the above-described well as filed and that the same are true and correct. So help me God.

(Signature) G. V. Kersten, Area Production Manager
316 Union Center Building, Wichita, Kansas 67202
(Address)

SUBSCRIBED AND SWORN TO before me this 17th day of DECEMBER, 19 63

My commission expires June 3, 1965

C. C. LEWIS, NOTARY PUBLIC
Notary Public.

BUNNELL WELL NO. 1

NE NE
Section 6-29S-30W
Gray County, Kansas

CONTRACTOR: THE R. W. RINE DRILLING COMPANY

STARTED: November 30, 1963

COMPLETED: December 16, 1963

L O G

Surface Clay, Sand, Red Bed	0' - 987'	Totco @ 100', 1/4°; @ 600', 1/2°
Red Bed, Sand	987' - 1457'	Totco @ 1000', 1/2°
Gyp, Red Bed, Anhydrite	1457' - 1771'	Totco @ 1771', 1°; 8-5/8" csg. @ 1741' w/725 sx type A Cement
Red Bed, Shale	1771' - 2050'	
Salt, Shale, Lime	2050' - 2430'	
Lime & Shale	2430' - 2804'	Totco @ 2440', 3/4°
Lime	2804' - 2933'	Totco @ 2800', 3/4°
Lime & Shale	2933' - 3178'	Totco @ 2955', 1°
Lime	3178' - 3270'	Totco @ 3180', 3/4°
Lime & Shale	3270' - 3366'	Totco @ 3355', 3/4°
Lime	3366' - 3630'	
Lime & Shale	3630' - 3879'	
Lime & Soft Lime	3879' - 4000'	
Lime	4000' - 4077'	Totco @ 4070', 1-3/4°
Lime & Shale	4077' - 4340'	Totco @ 4250', 1-1/2°
Lime	4340' - 5376'	Totco @ 4390', 3/4°; 4580', 1°, 4979', 1-1/4°; 5110', 1-1/4°
Hard Lime	5376' - 5421'	
Lime	5421' - 5444'	
Lime & Chert	5444' - 5488'	
Lime	5488' - 5503'	D & A Plug @ 5503' w/20 sx; 30 sx @ 1600'; wooden plug @ 40' & fill within 3' of G.L.

RECEIVED
 STATE CORPORATION COMMISSION
 DEC 31 1963
 CONSERVATION DIVISION
 Wichita, Kansas

STATE OF KANSAS)
COUNTY OF SEDGWICK) ss

I, R. M. Green, do hereby certify that the above is a true and accurate log of the BUNNELL WELL NO. 1, located NE NE of Section 6-29S-30W, Gray County, Kansas.

R. M. Green
R. M. Green, Secretary-Treasurer

Subscribed and sworn to before me this 20th day of December, 1963.

Loren E. Lake
Loren E. Lake, Notary Public

My Commission Expires: 6/14/66