


Give All Information Completely
Make Required Affidavit
Mail or Deliver Report to:
Conservation Division
State Corporation Commission
212 No. Market
Wichita, Kansas

WELL PLUGGING RECORD

Kingman County. Sec. 11 Twp. 29 Rge. 9W ~~(E)~~ (W)
Location as "NE/CNW&SW" or footage from lines SW NE SE
Lease Owner Conrardy Joint Venture c/o C. E. Ridley
Lease Name Conrardy Well No. 2
Office Address Box 484 Great Bend, Kansas
Character of Well (completed as Oil, Gas or Dry Hole) Oil
Date well completed _____ 19____
Application for plugging filed _____ 19____
Application for plugging approved _____ 19____
Plugging commenced _____ 19____
Plugging completed February 24, 19 61
Reason for abandonment of well or producing formation _____

NORTH

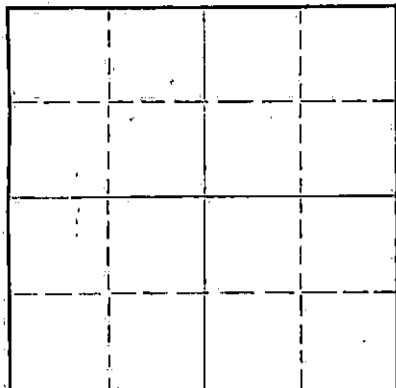

Locate well correctly on above
Section Plat

If a producing well is abandoned, date of last production _____ 19____
Was permission obtained from the Conservation Division or its agents before plugging was commenced? yes

Name of Conservation Agent who supervised plugging of this well Fred Hampel
Producing formation _____ Depth to top _____ Bottom _____ Total Depth of Well 4530' Feet
Show depth and thickness of all water, oil and gas formations.

OIL, GAS OR WATER RECORDS

CASING RECORD

FORMATION	CONTENT	FROM	TO	SIZE	PUT IN	PULLED OUT

Describe in detail the manner in which the well was plugged, indicating where the mud fluid was placed and the method or methods used in introducing it into the hole. If cement or other plugs were used, state the character of same and depth placed, from _____ feet to _____ feet for each plug set.

T.D. 4530' - 8 5/8" - 150 Cwc - 5 1/2" 4529' - 150 sacks cement.
Top Perf. 4494'
Bottom-sand to 4475' added 5 sacks cement
Pushed plug to 300' - pumped with bailer
15 sacks cement. 10' R. B. 145' - 10sacks cement
Plug at 300' - 15 sacks cement
10' R. B. - 145' - 10 sacks cement
R. B. - 30' - 10 sacks cement

RECEIVED
THE KANSAS STATE CORPORATION COMMISSION
MAR 25 1966
WICHITA, KANSAS

(If additional description is necessary, use BACK of this sheet)
Name of Plugging Contractor Southwest Casing Pulling Company 3-25-66
Address Box 364 Great Bend, Kansas

STATE OF Kansas, COUNTY OF Barton, ss.
Sidney D. Miller - President (employee of owner) or (owner or operator) of the above-described well, being first duly sworn on oath, says: That I have knowledge of the facts, statements, and matters herein contained and the log of the above-described well as filed and that the same are true and correct. So help me God.

(Signature) Sidney D. Miller Pres
Great Bend, Kansas
(Address)

SUBSCRIBED AND SWORN to before me this 24 day of March 19 66

My commission expires Feb. 28, 1968
Wanda C. Spencer Notary Public.

COPY


WELL LOG BUREAU - KANSAS GEOLOGICAL SOCIETY
506 East Marlock, Wichita, Kansas

Company: AYLWARD DRILLING CO., ETAL
Farm: Conrardy No. 2

SEC. 11 T. 29 R. 9W
SW NE SE

Total Depth: 4530'
Comm. 12-27-54 Comp. 1-8-55
Shot or Treated.
Contractor: Aylward Drilg. Co.
issued. 5-7-55

County Kingman
KANSAS

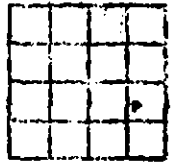

Elevation. 1703 DE

Production. 3,000 BOPD

Figures indicate Bottom of Formations

sand-clay	20
lime	30
sand	60
sand-shells	120
red bed	994
shale-shells salt	1360
Anhydrite-lime	1415
lign/shale strks	1528
lime-shale	3560
lime w/sand	3630
sdv lime	3682
lime	3742
lime-shale	3820
lime	3865
lime-shale	4265
lime-shale strks	4303
shale-lime	4530
Total Depth	

TOPS:	
Heebner	3342
Toronto	3358
Douglas	3379
Lansing	3559
Mississippian	4206
Viola	4495

DST #1 - 4496 (-2791) -
4502 (-2797) Open 45 min.,
gas to surface 17 min.,
rec. 3180' oil, FP 465#
to 780#, BHP 1485#/30 min.,
Hyd. 2380# (9.75# mud)
(intermittent plugging thru-
out test).

CABLE TOOL DATA
Perforated 20 holes from
4494-4497

RECEIVED
STATE CORPORATION COMMISSION
JUL 16 1964
CONSERVATION DIVISION
Wichita, Kansas