


STATE OF KANSAS
STATE CORPORATION COMMISSION

Give All Information Completely
Make Required Affidavit
Mail or Deliver Report to:
Conservation Division
State Corporation Commission
212 No. Market
Wichita, Kansas

WELL PLUGGING RECORD

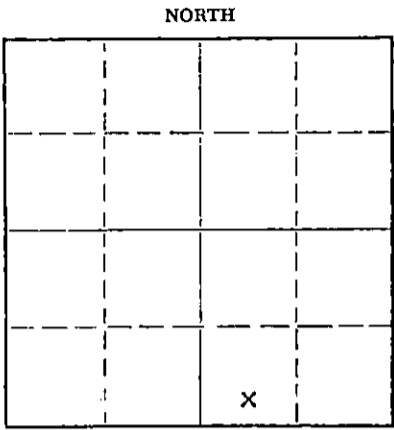

Locate well correctly on above Section Plat

Kingman County. Sec. 11 Twp. 29 Rge. 9 (E) (W)
Location as "NE/CNW/SW" or footage from lines SW SW SE
Lease Owner Bachus Oil Co.
Lease Name Conrardy A Well No. 1
Office Address 721 East Central Wichita, Kansas
Character of Well (completed as Oil, Gas or Dry Hole) _____
Date well completed _____ 19____
Application for plugging filed 7-9-68 19____
Application for plugging approved 7-10-68 19____
Plugging commenced 7-19-68 19____
Plugging completed 7-22-68 19____
Reason for abandonment of well or producing formation depleted

If a producing well is abandoned, date of last production _____ 19____
Was permission obtained from the Conservation Division or its agents before plugging was commenced? yes

Name of Conservation Agent who supervised plugging of this well Ralph Warren
Producing formation _____ Depth to top _____ Bottom _____ Total Depth of Well 3088 Feet
Show depth and thickness of all water, oil and gas formations.

OIL, GAS OR WATER RECORDS

CASING RECORD

FORMATION	CONTENT	FROM	TO	SIZE	PUT IN	PULLED OUT
				8 5/8	311'	none
				5 1/2	3034'	2090'

Describe in detail the manner in which the well was plugged, indicating where the mud fluid was placed and the method or methods used in introducing it into the hole. If cement or other plugs were used, state the character of same and depth placed, from _____ feet to _____ feet for each plug set.

Set 10' rock bridge from 2380' to 2370' and dump 5 sacks of cement
Set 15' rock bridge from 250' to 235' and dump 25 sacks of cement
Mud hole to 40', rock to 30' and dump 10 sacks of cement to surface

RECEIVED
STATE CORPORATION COMMISSION
AUG 1 1968
CONSERVATION DIVISION
Wichita, Kansas

8-1-68


(If additional description is necessary, use BACK of this sheet)
Name of Plugging Contractor Flint Engine ring and Const. Co.
Address 2375 W. Central El Dorado, Kansas

STATE OF Kansas, COUNTY OF Butler, ss.
_____(employee of owner) or (owner or operator) of the above-described well, being first duly sworn on oath, says: That I have knowledge of the facts, statements, and matters herein contained and the log of the above-described well as filed and that the same are true and correct. So help me God.

(Signature) Kenneth M. Smith

(Address) _____

Subscribed and Sworn to before me this 30 day of July, 1968

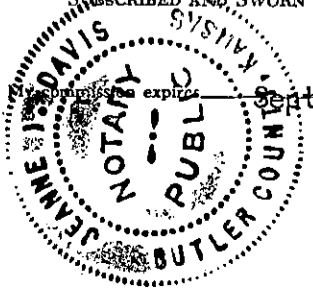

My commission expires Sept. 19, 1971

Jeanne P. Davis
Notary Public.