


15095-00545-00 00

STATE OF KANSAS
STATE CORPORATION COMMISSION
Give All Information Completely
Make Required Affidavit
Mail or Deliver Report to:
Conservation Division
State-Corporation Commission
211 No. Broadway
Wichita, Kansas

WELL PLUGGING RECORD

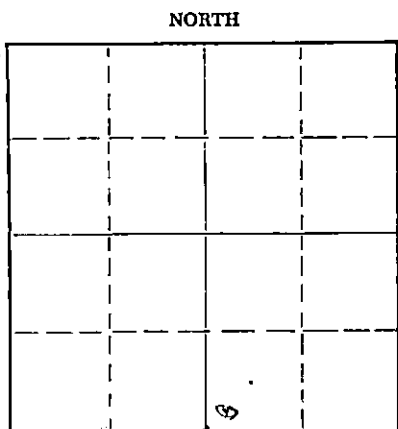

Kingman County. Sec. 11 Twp. 29 Rge. 9 (E) W. (W)
Location as "NE/CNW/SW" or footage from lines 330' N. & 330' E. of S/4 Cor.
Lease Owner Cities Service Oil Company
Lease Name Conrardy Well No. 2
Office Address Box 144, Great Bend, Kansas
Character of Well (completed as Oil, Gas or Dry Hole) Oil
Date well completed October 3 19 54
Application for plugging filed February 20 19 59
Application for plugging approved February 25 19 59
Plugging commenced March 10 19 59
Plugging completed March 14 19 59
Reason for abandonment of well or producing formation Depleted formation.

If a producing well is abandoned, date of last production February 21 19 59
Was permission obtained from the Conservation Division or its agents before plugging was commenced? Yes

Name of Conservation Agent who supervised plugging of this well Fred Hampel
Producing formation Viola Depth to top 4484' Bottom 4498' Total Depth of Well 4514 Feet
Show depth and thickness of all water, oil and gas formations. P. B. T. D. 4498 Feet

OIL, GAS OR WATER RECORDS

CASING RECORD

FORMATION	CONTENT	FROM	TO	SIZE	PUT IN	PULLED OUT
				8-5/8"	311'	None
				5-1/2"	4514'	3285

Describe in detail the manner in which the well was plugged, indicating where the mud fluid was placed and the method or methods used in introducing it into the hole. If cement or other plugs were used, state the character of same and depth placed, from _____ feet to _____ feet for each plug set.

- 4498-4450', river sand.
- 4450-4410', 5 sacks cement.
- 4410- 300', heavy mud.
- 300- 240', rock bridge and 20 sacks cement.
- 240- 30', heavy mud.
- 30' to base of cellar, rock bridge and 10 sacks cement.

RECEIVED
STATE CORPORATION COMMISSION
MAR 25 1959
CONSERVATION DIVISION
Wichita, Kansas

(If additional description is necessary, use BACK of this sheet)
Name of Plugging Contractor C. E. Shull Casing Pulling Co.
Address Great Bend, Kansas

STATE OF Kansas, COUNTY OF Barton, ss.
V. M. Conover (employee of owner) or ~~owner or operator~~ of the above-described well, being first duly sworn on oath, says: That I have knowledge of the facts, statements, and matters herein contained and the log of the above-described well as filed and that the same are true and correct. So help me God.

(Signature) V. M. Conover
Box 144, Great Bend, Kansas
(Address)

SUBSCRIBED AND SWORN TO before me this 23rd day of March, 19 59
W. D. Smith
Notary Public.

My commission expires March 12, 1963.

PLUGGING
FILE SEC. 11 T. 29 R. 9 W
BOOK PAGE 25 LINE 28

WELL RECORD

Company Citizen Service Oil Co. Well No. 2 Farm Conrardy
 Location 330' N. & 330' E. of 3/4 Cor. Sec. 11 T. 29 R. 9W
 Elevation 1703 (1700 Gr.) County Kingman State Kansas
 Drlg. Comm. September 17, 1954 Contractor Harbour Drilling Company
 Drlg. Comp. October 3, 1954 Acid None
 T. D. 4514' Initial Prod. Physical Potential (Flow) 202 oil, 0 water, 24 hrs.
 P. B. T. D. 4498' (10-25-54)

CASING RECORD:

8-5/8" @ 311' cem. 225 ex cement
 5-1/2" @ 4514' cem. 150 ex cement

FORMATION RECORD:

soil & sand	0-140
red bed & shale	313
red bed & shells	460
shale & shells	1790
shale & lime	2060
lime & shale	2370
shale & shells	2580
shale & lime	2675
shale	2780
shale & lime	2950
lime	3475
sandy lime	3550
lime	4295
cherty lime & shale	4340
shale	4485
lime & chert	4515

4515 ITD = 4514 SLM

Corr. Lansing	3555'
Corr. Mississippi	4211'
Corr. Kinderhook	4308'
Corr. Viola	4484'
Penetration	35'
Total Depth	4514'

Drilled cement to 4498' SLM.

Loaded hole with 50 bbls. water.

Perf. 29 shots 4484-91.

SYFO:	260'	0°
	750'	1°
	1000'	1°
	1500'	0°
	2000'	1°
	2500'	1°
	3000'	0°
	3500'	1°

RECEIVED
 STATE COMMISSION

FEB 24 1959
 CONSERVATION DIVISION
 Wichita, Kan.

PLUGGING	
FILE NO.	11 T. 29 R. 9W
BOOK	PAGE 16 LINE 28