


STATE OF KANSAS
STATE CORPORATION COMMISSION
CONSERVATION DIVISION
P. O. BOX 17027
WICHITA, KANSAS 67217

FORM CP-4

WELL PLUGGING RECORD

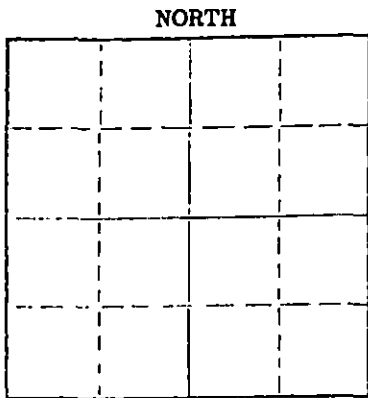

Locate well correctly on above Section Plat

Kingman County, Sec. 11 Twp. 29 Rge. 9 (E) (W)
Location as "NE/CNW/SW" or footage from lines NW SW SE
Lease Owner A. Scott Ritchie
Lease Name Conady A#1 Well No. _____
Office Address Wichita, Kansas
Character of Well (completed as Oil, Gas or Dry Hole) _____
Date well completed _____ 19____
Application for plugging filed _____ 19____
Application for plugging approved _____ 19____
Plugging commenced 1/19/76 _____ 19____
Plugging completed 1/21/76 _____ 19____
Reason for abandonment of well or producing formation depleted.

If a producing well is abandoned, date of last production _____ 19____
Was permission obtained from the Conservation Division or its agents before plugging was commenced? yes

Name of Conservation Agent who supervised plugging of this well Biberstein
Producing formation _____ Depth to top _____ Bottom _____ Total Depth of Well 2505 Feet
Show depth and thickness of all water, oil and gas formations.

OIL, GAS OR WATER RECORDS				CASING RECORD		
FORMATION	CONTENT	FROM	TO	SIZE	PUT IN	PULLED OUT
				8-5/8	222	none
				4 1/2"	2499	1938'

Describe in detail the manner in which the well was plugged, indicating where the mud fluid was placed and the method or methods used in introducing it into the hole. If cement or other plugs were used, state the character of same and depth placed, from _____ feet to _____ feet for each plug set.

Pushed plug to 2400' and ran 20' of sand and 4 sacks cement.
Loaded hole, shot pipe at 1965', pulled 61 joints of 4 1/2" casing.
Bailed hole to 220' and set 10' rock bridge, ran 3 yards ready mix.

PLUGGING COMPLETE.

(If additional description is necessary, use BACK of this sheet)
Name of Plugging Contractor KELSO CASING PULLING
Address CHASE, KANSAS

STATE OF KANSAS COUNTY OF RICE, ss.
R. DARRELL KELSO (employee of owner) or (owner or operator) of the above-described well, being first duly sworn on oath, says: That I have knowledge of the facts, statements, and matters herein contained and the log of the above-described well as filed and that the same are true and correct. So help me God.

(Signature) R. Darrell Kelso
CHASE, KANSAS
(Address)

SUBSCRIBED AND SWORN TO before me this 28th day of January, 19 76

My commission expires _____

MARGARET MELCHER
Rice County, Ks.
My Comm. Exp. Feb. 15, 1979

Margaret Melcher
Notary Public.

RECEIVED
STATE CORPORATION COMMISSION

JAN 30 1976

CONSERVATION DIVISION
Wichita, Kansas

ROTARY DRILLERS' LOG

OPERATOR: A. Scott Ritchie COMMENCED: 11-25-70
Union Center
Wichita, Kansas

CONTRACTOR: Graves Drilling Co., Inc. COMPLETED: 11-29-70
505 Union Center
Wichita, Kansas

SURFACE CASING: Set with 8 5/8" casing LOCATION: Conrardy # 1
at 222.31', with 250 NW SW SE
sacks of cement. 11-29-9W
Kingman County, Ks.

0	-	90	sand
90	-	220	Cement
220	-	840	red bed & shale
840	-	1375	shale-shells
1375	-	2402	lime & shale
2402	-	2446	sand
2446	-	2502	shale & lime

I hereby certify the foregoing to be correct to the best of my knowledge.

RECEIVED
STATE CORPORATION COMMISSION

JAN 16 1976

CONSERVATION DIVISION
Wichita, Kansas

GRAVES DRILLING CO., INC.

By *John C. Graves*
John C. Graves, President

My commission expires July 28, 1974

Mary Ann Scott
Mary Ann Scott, Notary Public

Original has been mailed to Corp. Commission.