

15-097-10040-00-00

STATE OF KANSAS  
STATE CORPORATION COMMISSION


Give All Information Completely  
Make Required Affidavit  
Mail or Deliver Report to:  
Conservation Division  
State Corporation Commission  
11 No. Broadway  
Wichita, Kansas

WELL PLUGGING RECORD

Kiowa County. Sec. 19 Twp. 29S Rge. 16 (W)

Location as "NE/CNW/SW" or footage from lines NE SW  
Lease Owner Graybol Oil Corporation  
Lease Name Library Well No. 1  
Office Address 2200 National Bank of Tulsa Building, Tulsa, Oklahoma  
Character of Well (completed as Oil, Gas or Dry Hole) Dry Hole  
Date well completed December 9 19 62  
Application for plugging filed December 10 19 62  
Application for plugging approved December 10 19 62  
Plugging commenced December 10 19 62  
Plugging completed December 10 19 62  
Reason for abandonment of well or producing formation Dry Hole

NORTH

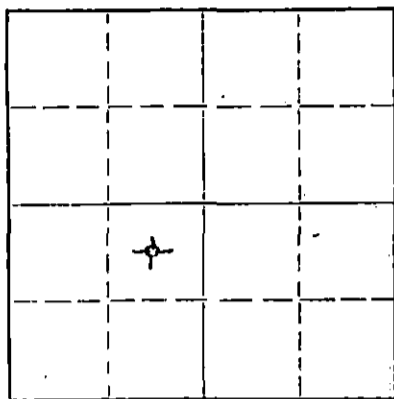

Locate well correctly on above  
Section Plat

If a producing well is abandoned, date of last production \_\_\_\_\_ 19\_\_\_\_  
Was permission obtained from the Conservation Division or its agents before plugging was commenced? Yes

Name of Conservation Agent who supervised plugging of this well Herman Justus  
Producing formation None Depth to top \_\_\_\_\_ Bottom \_\_\_\_\_ Total Depth of Well 4785 Feet  
Show depth and thickness of all water, oil and gas formations.

OIL, GAS OR WATER RECORDS

CASING RECORD

FORMATION	CONTENT	FROM	TO	SIZE	PUT IN	PULLED OUT
Douglas Sand	Water	3966	4008	8 5/8"	272'	None
Lansing Lime	Water	4105	4490			
Mississippi Chat	Impermeable	4656	4719			
Viola Lime	Water	4733	4785			

Describe in detail the manner in which the well was plugged, indicating where the mud fluid was placed and the method or methods used in introducing it into the hole. If cement or other plugs were used, state the character of same and depth placed, from \_\_\_\_\_ feet to \_\_\_\_\_ feet for each plug set.

Filled hole with heavy mud-laden fluid. Pushed plug to 240'. Cemented with 20 sacks Portland cement. Plugged top 40' of surface casing with ten sacks Portland cement. Placed two sacks of Portland cement in rat hole.

RECEIVED  
STATE CORPORATION COMMISSION

DEC 13 1962

CONSERVATION DIVISION  
Wichita, Kansas

12-13-62

(If additional description is necessary, use BACK of this sheet)  
Name of Plugging Contractor Graybol Oil Corporation  
Address 2200 National Bank of Tulsa Building, Tulsa, Oklahoma

STATE OF OKLAHOMA, COUNTY OF Tulsa, ss.  
Lyman C. Dennis (employee of owner) or (~~Notary Public~~) of the above-described well, being first duly sworn on oath, says: That I have knowledge of the facts, statements, and matters herein contained and the log of the above-described well as filed and that the same are true and correct. So help me God.

(Signature) Lyman C. Dennis  
Tulsa, Oklahoma (Address)

SUBSCRIBED AND SWORN TO before me this 12th day of December, 19 62

My commission expires October 8, 1966

Paul Corrigan  
Notary Public.

GRAYBOL OIL CORPORATION

Kiowa County, Kansas

No. 1 Library

NE SW Section 19-29S-16W

Contractor: Company Tools

Elev: 2002' K.B. 2002' D.F.  
1997' G.L.

Commenced: November 21, 1962

Completed: December 9, 1962

Production: Dry and Abandoned:

CASING RECORD

Set 8 5/8" casing at 272' with 160 sacks of cement.

<u>DEPTH</u>	<u>FORMATION</u>	<u>WELEX ELECTRIC LOG TOPS:</u>
0-40	Top soil and sand.	Anhydrite 898
40-275	Shale and shells	Topeka 3455
275-680	Shale and red bed	Heebner 3925
680-905	Red bed and sand	Douglas 3966
905-920	Anhydrite	Brown Lime 4088
920-1840	Shale and shells	Lansing 4105
1840-2065	Shale and lime	Base of Kansas City 4490
2065-2170	Lime and shale streaks	Marmaton 4506
2170-2285	Lime and shale	Mississippi Chat 4656
2285-2430	Lime	Kinderhook 4719
2430-2535	Lime and shale	Viola 4733
2535-2605	Lime	Walex T. D. 4789
2605-3095	Shale and lime	
3095-3210	Lime and shale	
3210-3385	Shale and lime	
3385-3453	Lime and shale	
3453-3500	Shale and lime	
3500-3538	Shale and lime streaks	
3538-3655	Shale and Lime	
3655-3915	Lime	
3915-3965	Lime and shale	
3965-4005	Douglas sand	
4005-4080	Lime and shale streaks	
4080-4130	Lime and shale	
4130-4185	Shale, lime and chalk streaks	
4185-4236	Lime and shale	
4236-4500	Lime	
4500-4545	Lime and shale	
4545-4595	Shale and lime	
4595-4671	Lime and shale	
4671-4717	Lime	
4717-4785	Lime and shale	
Driller's Total Depth	4785'	

RECEIVED  
STATE CORPORATION COMMISSION

DEC 13 1962

CONSERVATION DIVISION  
Wichita, Kansas

I hereby certify that the above is a true and correct log of the above-captioned well as taken directly from the daily drilling reports.

GRAYBOL OIL CORPORATION

By: Lyman C. Dennis  
Lyman C. Dennis, Geologist

STATE OF OKLAHOMA

COUNTY OF TULSA

Subscribed and sworn to this 12th day of December, 1962.

My commission expires: October 8, 1966

Jean Carrigan  
NOTARY PUBLIC