

15-097-10070-00-00


STATE OF KANSAS
STATE CORPORATION COMMISSION

Give All Information Completely
Make Required Affidavit
Mail or Deliver Report to:
Conservation Division
State Corporation Commission
211 No. Broadway
Wichita, Kansas

WELL PLUGGING RECORD

Kiowa County, Sec. 15 Twp. 29S Rge. 16 (W)
Location as "NE/CNW/SW" or footage from lines 580' EWL & 330' SNL of NW/4

Lease Owner Gulf Oil Corporation
Lease Name O. Rezeau Well No. 1
Office Address Box 661, Tulsa, Oklahoma
Character of Well (completed as Oil, Gas or Dry Hole) oil
Date well completed 5-10 19 55
Application for plugging filed 5-1 19 57
Application for plugging approved 5-3 19 57
Plugging commenced 6-13 19 57
Plugging completed 6-16 19 57
Reason for abandonment of well or producing formation well operating below it's economic limit.

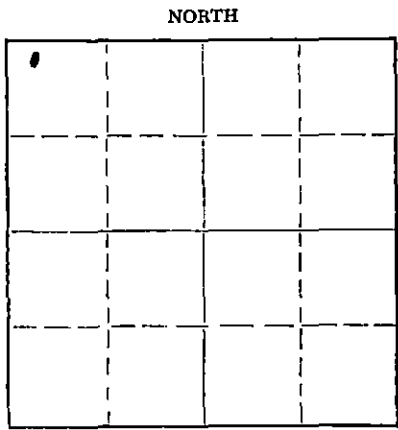

Locate well correctly on above Section Plat

If a producing well is abandoned, date of last production 2-22 19 57

Was permission obtained from the Conservation Division or its agents before plugging was commenced? yes

Name of Conservation Agent who supervised plugging of this well M. A. Rives
Producing formation Mississippi Depth to top 1637' Bottom 1695' Total Depth of Well 1695 Feet
Show depth and thickness of all water, oil and gas formations.

OIL, GAS OR WATER RECORDS

CASING RECORD

FORMATION	CONTENT	FROM	TO	SIZE	PUT IN	PULLED OUT
				8-5/8"	351'	-0-
				5-1/2"	1693'	3962.55'

Describe in detail the manner in which the well was plugged, indicating where the mud fluid was placed and the method or methods used in introducing it into the hole. If cement or other plugs were used, state the character of same and depth placed, from _____ feet to _____ feet for each plug set.

Filled with sand to 1630', Dumped 5 sx. cement on top of sand. Filled with mud to 300', placed rock bridge and dumped 20 sx. cement. Filled with mud to 35', placed rock bridge and capped with 10 sx. cement.

(If additional description is necessary, use BACK of this sheet)

Name of Plugging Contractor Morgan Well Plugging Service
Address 102 W 18th St., Hutchinson, Kansas

STATE OF Kansas, COUNTY OF Sedgwick, ss.
Thomas A. Trax (employee of owner) ~~owner or operator~~ of the above-described well, being first duly sworn on oath, says: That I have knowledge of the facts, statements, and matters herein contained and the log of the above-described well as filed and that the same are true and correct. So help me God.

(Signature) Thomas A. Trax
Thomas A. Trax, Asst. Zone Supt. of Prod.
Box 2233, Wichita, Kansas

SUBSCRIBED AND SWORN to before me this 17th day of June, 19 57

My commission expires 6-3-61

W. G. Lewis
Notary Public.

PLUGGING
FILE SEC 15 T 29 R 16W
BOOK PAGE 10 LINE 30

6-21-57

CONSERVATION DIVISION

JFM:RAW

GULF OIL CORPORATION

ORPHA REZEAU NO. 1

NW NW NW Sec. 15-29S-16W

Kiowa County, Kansas

DRILLER'S LOG

Commenced Drilling - 4/19/55.
 Completed Drilling - 5/2/55.
 Set - 354' - 8-5/8" casing
 Cemented w/285 sacks.
 Set - 4693' - 5-1/2" casing
 Cemented w/100 sacks.

Surface Soil & Gravel	0	40
Red Bed & Shells	40	365
Red Bed & Shale	365	475
Shale & Lime	475	1110
Red Bed & Shells	1110	1700
Shale & Lime	1700	2105
Lime & Sand	2105	2245
Lime, Shale & Sdy. Lime	2245	2348
Shale & Lime	2348	2568
Sdy. Shale & Lime	2568	2669
Shale & Lime	2669	2759
Broken Lime & Shale	2759	2835
Shale & Lime	2835	3004
Sdy. Lime, Shale & Lime	3004	3120
Shale	3120	3260
Broken Shale & Lime	3260	3365
Lime & Shale Stks.	3365	3406
Shale & Lime	3406	3523
Lime	3523	3562
Sand, Lime & Shale	3562	3705
Shale & Lime	3705	3970
Shale	3970	4085
Lime & Shale	4085	4104
Lime	4104	4199
Lime & Shale	4199	4598
Lime, Shale & Chat	4598	4647
Lime	4647	4682
Lime & Shale	4682	4695
Total Depth	4695	

RECEIVED
 STATE CORPORATION COMMISSION
 MAY 3 - 1957

CONSERVATION DIVISION
 Kansas

I hereby certify that the foregoing is a true and correct copy of the Orpha Rezeau No. 1 Well Driller's Log, as it is recorded in the log books of Falcon Seaboard Drilling Company.

J. O. Brown

Subscribed and sworn to before me this 19th day of August, 1955.

RECEIVED
 STATE CORPORATION COMMISSION
 MAY 3 - 1957

CONSERVATION DIVISION
 Kansas

My commission expires February 8, 1958.

Notary Public

PLUGGING
 FILE: SEC 15 T 29 R 16W
 BOOK: PAGE 10 LINE 30