

15-011-20911-00-00


STATE OF KANSAS
STATE CORPORATION COMMISSION

WELL PLUGGING RECORD

Give All Information Completely
Make Required Affidavit
Mail or Deliver Report to
Conservation Division
State Corporation Comm.
245 North Water
Wichita, KS 67202

Kiowa County, Sec. 18 Twp. 29S Rge. 16 E/W
Location as "NE/CNW 1/4 SW 1/4" or footage from lines

Lease Owner Cinco Exploration Company
Lease Name John W. Bundren Well No. 1
Office Address P. O. Box 3723 Victoria, TX 77901
Character of Well (Completed as Oil, Gas or Dry Hole) Dry Hole
Date Well completed 10-25-82 1982
Application for plugging filed 10-25-82 1982
Application for plugging approved 10-25 1982
Plugging commenced 10-25 1982
Plugging completed 10-25 1982
Reason for abandonment of well or producing formation Dry hole

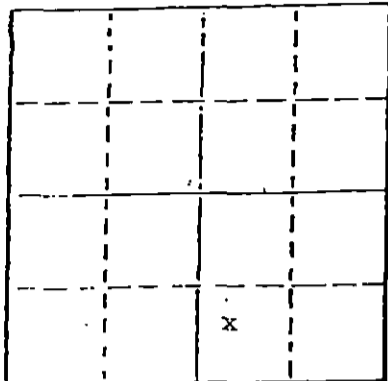

Locate well correctly on above Section Plat

If a producing well is abandoned, date of last production 19

Was permission obtained from the Conservation Division or its agents before plugging was commenced? Yes

Name of Conservation Agent who supervised plugging of this well Steve Durrant

Producing formation Depth to top Bottom Total Depth of Well

Show depth and thickness of all water, oil and gas formations.

OIL, GAS OR WATER RECORDS

CASING RECORD

FORMATION	CONTENT	FROM	TO	SIZE	PUT IN	PULLED OUT
				4 1/4	8 5/8	

Describe in detail the manner in which the well was plugged, indicating where the mud fluid was placed and the method or methods used in introducing it into the hold. If cement or other plugs were used, state the character of same and depth placed, from feet to feet for each plug set.

70 sks @ 960'

40 sks @ 420'

10 sks @ 40'

10 sks in rat hole

10 sks in mouse hole

5 sks in water well

(If additional description is necessary, use BACK of this sheet)

Name of Plugging Contractor Eagle Drilling, Inc.

STATE OF Kansas COUNTY OF Sedgwick, ss.
Robert L. Eisel (employee of owner) or (owner or operator)
of the above-described well, being first duly sworn on oath, says: That I have knowledge of the facts, statements, and matters herein contained and the log of the above-described well as filed and that the same are true and correct. So help me God.

(Signature)

Robert L. Eisel

(Address)

SUBSCRIBED AND SWORN TO before me this 1st day of November, 1982

Maureen E. Gile

Maureen E. Gile Notary Public.

My commission expires September 28, 1983

RECEIVED
STATE CORPORATION COMMISSION

NOV 3 1982 11-3-82

CONSERVATION DIVISION
Wichita, Kansas

