


15-097-10023-00-00

STATE OF KANSAS
STATE CORPORATION COMMISSION
Give All Information Completely
Make Required Affidavit
Mail or Deliver Report to:
Conservation Division
State Corporation Commission
212 North Market, Insurance Bldg.
Wichita, Kansas

WELL PLUGGING RECORD

Kiowa County, Sec. 23 Twp. 29 S Rge. (E) 16 (W)
Location as "NE/CNW/SW" or footage from lines SE/4 SE/4 NE/4
Lease Owner Messman-Rinehart Oil Company
Lease Name Piester "A" Well No. 1
Office Address 518 Petroleum Building, Wichita, Kansas
Character of Well (completed as Oil, Gas or Dry Hole) Oil
Date well completed June 26 19 55
Application for plugging filed November 5 19 60
Application for plugging approved November 21 19 60
Plugging commenced December 26 19 60
Plugging completed December 30 19 60
Reason for abandonment of well or producing formation Depleted reservoir

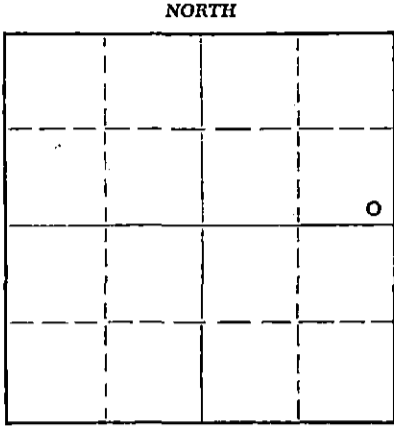

If a producing well is abandoned, date of last production September 29 19 60
Was permission obtained from the Conservation Division or its agents before plugging was commenced? yes

Name of Conservation Agent who supervised plugging of this well W. L. Lackamp, Stafford, Kansas
Producing formation _____ Depth to top _____ Bottom _____ Total Depth of Well 4660 Feet
Show depth and thickness of all water, oil and gas formations.

OIL, GAS OR WATER RECORDS						CASING RECORD	
FORMATION	CONTENT	FROM	TO	SIZE	PUT IN	PULLED OUT	
				8-5/8"	352'	none	
				5-1/2"	4660'	3900	

Describe in detail the manner in which the well was plugged, indicating where the mud fluid was placed and the method or methods used in introducing it into the hole. If cement or other plugs were used, state the character of same and depth placed, from _____ feet to _____ feet for each plug set.

Bailed fluid to 320 ft., Set 10 ft. rock bridge at 320 ft., mixed and ran 20 sx. cement. Mud to 40 ft., set 10 ft. rock bridge, with 10 sx. cement to base of cellar.

RECEIVED
STATE CORPORATION COMMISSION
JAN 16 1961
CONSERVATION DIVISION
Wichita, Kansas

(If additional description is necessary, use BACK of this sheet)
Name of Plugging Contractor Southwest Casing Pulling Co. - License No. 399
Address Great Bend, Kansas

STATE OF Kansas COUNTY OF Sedgwick, ss.
J. A. Gilliland (employee of owner) or (owner or operator) of the above-described well, being first duly sworn on oath, says: That I have knowledge of the facts, statements, and matters herein contained and the log of the above-described well as filed and that the same are true and correct. So help me God.
(Signature) J. A. Gilliland
518 Petroleum Building, Wichita, Kansas (Address)

SUBSCRIBED AND SWORN TO before me this 11th day of January, 19 61
Barbara J. Scott
Barbara J. Scott, Notary Public.

My commission expires December 1, 1964

NO. 1 PIESTER "A"

Location: SE SE NE, 23-29S-16W
Kiowa County, Kansas

Commenced: May 24, 1955

Operator: Gramhart-Miller Oil Company
1005 East Second, Wichita, Kansas

Completed: June 7, 1955

Contractor: Graham-Messman-Rinehart Oil Company
1005 East Second, Wichita, Kansas

Elevation: 1956 KB

Production: Oil (5 3/4 Bopd/pot hole)

Casing Record: 8 5/8" @ 352' w/225 sacks cement
5 1/2" @ 4660' w/75 sacks cement

.....I O G.....

Surface Clay-Sand	40
Shale	140
Sand-Shale	185
Shale	205
Gyp	225
Shale	850
Anhydrite	873
Shale	1280
Shale-Shells	1780
Shale	2101
Shale-Broken Lime	2245
Shale-Lime	2512
Lime-Shale	2863
Shale-Lime Streaks	3025
Lime-Shale	3275
Brown Lime-Shale	3375
Lime-Shale	3490
Shale-Lime	3690
Lime	3970
Lime-Shale	4070
Lime	4572
Lime-Shale Streaks	4582
Coring	4621
Lime	4660 R.T.D.

SAMPLE TOPS:

- Heebner 3891 (-1935)
- Douglas Group 3945 (-1989)
- Brown Lime 4056 (-2100)
- Lansing 4072 (-2116)
- Cherokee Sd 4596 (-2640)
- Miss. Chert 4622 (-2666)

The undersigned, GRAHAM-MESSMAN-RINEHART OIL COMPANY, hereby certifies that the above log is a true and correct log of the formation encountered in drilling the above well as reflected by the Daily Drilling Report.

GRAHAM-MESSMAN-RINEHART OIL COMPANY

BY: J. A. Gilliland
J. A. Gilliland

Subscribed and sworn to before me this 15th day of June, 1955.

Walter L. Pours
Notary Public

My Commission Expires: November 5, 1958

RECEIVED
STATE CORPORATION COMMISSION
JAN 16 1961
CONSERVATION DIVISION
Wichita, Kansas