


STATE OF KANSAS  
STATE CORPORATION COMMISSION

WELL PLUGGING RECORD

Give All Information Completely  
Make Required Affidavit  
Mail or Deliver Report to  
Conservation Division  
State Corporation Comm.  
245 North Water  
Wichita, KS 67202

Pratt County. Sec. 31 Twp. 28S Rge. 14W  
Location as "NE/CNW $\frac{1}{4}$ SW $\frac{1}{4}$ " or footage from lines \_\_\_\_\_

C NE NW  
Lease Owner Hummon Corporation  
Lease Name Payne Well No. 1  
Office Address 400 One Main Place, Wichita, Kansas  
Character of Well (Completed as Oil, Gas or Dry Hole) \_\_\_\_\_  
Dry Hole

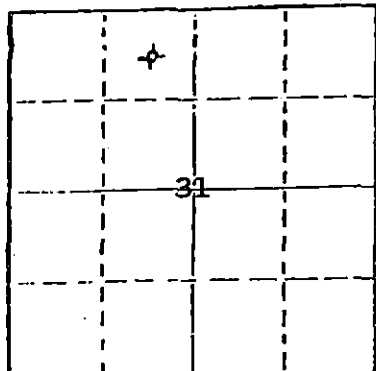

Locate well correctly on above  
Section Plat

Date Well completed April 14, 1980  
Application for plugging filed April 14, 1980  
Application for plugging approved April 14, 1980  
Plugging commenced April 14, 1980  
Plugging completed April 14, 1980  
Reason for abandonment of well or producing formation \_\_\_\_\_  
Dry Hole

If a producing well is abandoned, date of last production \_\_\_\_\_ 19\_\_\_\_

Was permission obtained from the Conservation Division or its agents before plugging was commenced? Yes

Name of Conservation Agent who supervised plugging of this well Wm. T. Owen  
Producing formation \_\_\_\_\_ Depth to top \_\_\_\_\_ Bottom \_\_\_\_\_ Total Depth of Well 4610'  
Show depth and thickness of all water, oil and gas formations.

OIL, GAS OR WATER RECORDS

CASING RECORD

FORMATION	CONTENT	FROM	TO	SIZE	PUT IN	PULLED OUT
		0'	382'	8-5/8"	375'	None

Describe in detail the manner in which the well was plugged, indicating where the mud fluid was placed and the method or methods used in introducing it into the hold. If cement or other plugs were used, state the character of same and depth placed, from \_\_\_\_\_ feet to \_\_\_\_\_ feet for each plug set.

Plugged with 35 sacks cement at 600',  
40 sacks cement at 390', 10 sacks cement  
at 40', and 5 sacks cement in rat hole.

RECEIVED  
STATE CORPORATION COMMISSION  
4-23-80  
APR 23 1980

(If additional description is necessary, use BACK of this sheet)


Name of Plugging Contractor Allied Cementing Co.

CONSERVATION DIVISION  
Wichita, Kansas

STATE OF KANSAS COUNTY OF SEDGWICK, ss.  
John D. Knightley Agent (employee of owner) or (owner or operator)  
of the above-described well, being first duly sworn on oath, says: That I have knowledge of the facts, statements, and matters herein contained and the log of the above-described well as filed and that the same are true and correct. So help me God.

(Signature) [Signature]  
221 S. Broadway, Wichita, Kansas 67202  
(Address)

SUBSCRIBED AND SWORN TO before me this 22nd day of April, 1980

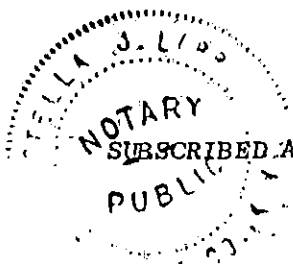

Stella J. Lipps  
Notary Public.

My commission expires March 12, 1983

Hummon Corporation  
400 One Main Place  
Wichita, Kansas 67202

Payne #1  
C NE NW Sec. 31-28S-14W  
Pratt County, Kansas

Contractor: D. R. Lauck Oil Company, Inc.  
221 S. Broadway, Suite 400  
Wichita, Kansas 67202

Commenced: April 7, 1980  
Completed: April 14, 1980

Drillers Log

Shale	95
Sand	250
Red Bed	890
Anhydrite	900
Red Bed & Shale	1065
Shale	2095
Shale & Shells	3370
Shale & Lime	4055
Lime	4260
Lime & Shale	4500
Lime	4580
Lime & Sand	4610 RTD

RECEIVED  
STATE CORPORATION COMMISSION

APR 23 1980

CONSERVATION DIVISION  
Wichita, Kansas