


STATE OF KANSAS
STATE CORPORATION COMMISSION

WELL PLUGGING RECORD

Give All Information Completely
Make Required Affidavit
Mail or Deliver Report to:
Conservation Division
State Corporation Commission
800 Bitting Building
Wichita, Kansas

Pratt County, Sec. 30 Twp. 28 Rge. (E) 14 (W)

Location as "NE/CNW $\frac{1}{4}$ /SW $\frac{1}{4}$ " or footage from lines NE SE NW
Lease Owner Lario Oil & Gas Company
Lease Name Eubank Estate "B" Well No. 1
Office Address 301 South Market, Wichita 2, Kansas
Character of Well (completed as Oil, Gas or Dry Hole) Dry Hole
Date well completed April 18, 19 54
Application for plugging filed (written) April 21, 19 54
Application for plugging approved (written) April 20, 19 54
Plugging commenced April 18, 19 54
Plugging completed April 18, 19 54
Reason for abandonment of well or producing formation Dry

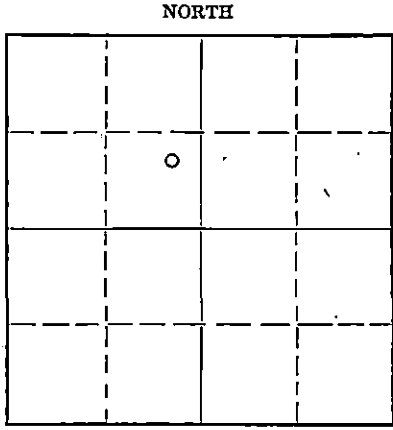

If a producing well is abandoned, date of last production 19
Was permission obtained from the Conservation Division or its agents before plugging was commenced? Yes

Name of Conservation Agent who supervised plugging of this well M. A. Rives, Box 8, Pratt Kansas
Producing formation Depth to top Bottom Total Depth of Well 4800 Feet
Show depth and thickness of all water, oil and gas formations.

OIL, GAS OR WATER RECORDS

CASING RECORD

Formation	Content	From	To	Size	Put In	Pulled Out
				8 5/8"	360	None

Describe in detail the manner in which the well was plugged, indicating where the mud fluid was placed and the method or methods used in introducing it into the hole. If cement or other plugs were used, state the character of same and depth placed, from feet to feet for each plug set.

Set plug at 300' and cemented with 20 sacks cement.
Set plug at 40' and cemented with 10 sacks cement.

RECEIVED
STATE CORPORATION COMMISSION
APR 22 1954
4-22-54
CONSERVATION DIVISION
Wichita, Kansas

(If additional description is necessary, use BACK of this sheet)
Name of Plugging Contractor Buick Drilling Company
Address St. John, Kansas

STATE OF KANSAS, COUNTY OF SEDGWICK, ss.
Leo Ross (employee of owner) or ~~owner or operator~~ of the above-described well,
being first duly sworn on oath, says: That I have knowledge of the facts, statements, and matters herein contained and the log of the above-described well as filed and that the same are true and correct. So help me God.

(Signature) *Leo Ross*
301 South Market, Wichita 2, Kansas
(Address)

SUBSCRIBED AND SWORN to before me this 21st day of April, 19 54
Frances Leslie
Notary Public.

My commission expires July 21, 1954

PLUGGING
SEE SEC 30 T28 R 14W
BOOK PAGE 28 LINE 15

LARIO OIL & GAS CO.
 Eubank Estate "B" No. 1
 NE SE NW Sec. 30-28S-14W.
 Pratt County, Kansas

Drilling Contractor: Buick Drilling, Inc.
 Drilling Commenced: March 22, 1954
 Drilling Completed: April 18, 1954
 Total Depth 4800'
 Dry & Abandoned

Casing Record:
 8 5/8" Set at 360' w/ 470 sxs. of
 Posmix

<u>Formation:</u>	<u>Depth:</u>
Shale & shells	105
Sand & gravel	195
Sand	275
Red bed	905
Anhydrite	930
Shale	1035
Shale & shells	1425
Shale & salt	1570
Shale & shells	2015
Brown lime & shale	2060
Lime	2280
Lime & shale	2365
Lime	2445
Lime & shale	3270
Lime	3385
Lime & shale	3444
Broken lime	3485
Lime	3550
Lime & shale	3610
Lime	3687
Lime & shale	3725
Lime, broken	3775
Lime	3825
Lime & shale	3935
Lime	3997
Lime & shale	4040
Lime	4094
Lime & shale	4101
Lime	4211
Lime & shale	4230
Lime	4274
Lime & shale	4300
Lime	4364
Lime & shale	4468
Lime, shale & chert	4492
Cherty lime & shale	4510
Lime	4520
Lime & shale	4535
Chert & shale	4545

<u>Formation:</u>	<u>Depth:</u>
Lime & shale	4580
Shale	4600
Lime & shale	4624
Broken lime	4649
Lime & shale	4670
Lime sandy	4692
Shale & lime	4764
Arbuckle lime	4800 R.T.D.

(Dry & Abandoned)

Geological Tops (Electric Log)

Elevation	2037 D.F.	2039 R.B.
Topeka	3257	-1216
Lansing-K.C.	4046	-1997
Conglomerate	4469	-2430
Mississippi	4520	-2481
Viola	4546	-2507
Simpson Shale	4668	-2628
Simpson Sand	4681	-2642
Arbuckle	4762	-2723
Schlumberger T.D.	4797	-2758

PLUGGING
 REC SEC 30 T 28 R 4
 BOOK PAGE 28 LINE 45

RECEIVED
 APR 22 1954
 CONSERVATION DIVISION
 Wichita, Kansas