


STATE OF KANSAS
STATE CORPORATION COMMISSION

Give All Information Completely
Make Required Affidavit
Mail or Deliver Report to:
Conservation Division
State Corporation Commission
212 No. Market
Wichita, Kansas

WELL PLUGGING RECORD

NORTH

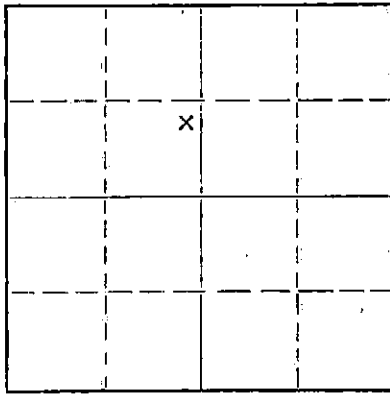

Locate well correctly on above
Section Plot

Pratt County, Sec. 30 Twp. 28 Rge. 14 (E) (W)
Location as "NE/CNW/SW" or footage from lines NE SE NW
Lease Owner H.C. Bennett
Lease Name Eubank Est. B Well No. 1
Office Address 1212 Union Nat'l Bldg. Wichita, Ks.
Character of Well (completed as Oil, Gas or Dry Hole) oil well
Date well completed 4-18-54 19
Application for plugging filed 5-2-68 19
Application for plugging approved 5-3-68 19
Plugging commenced 5-6-68 19
Plugging completed 5-9-68 19
Reason for abandonment of well or producing formation depleted

If a producing well is abandoned, date of last production 19
Was permission obtained from the Conservation Division or its agents before plugging was commenced? yes

Name of Conservation Agent who supervised plugging of this well Ralph Warren
Producing formation Depth to top Bottom Total Depth of Well 4538 Feet
Show depth and thickness of all water, oil and gas formations.

OIL, GAS OR WATER RECORDS

CASING RECORD

FORMATION	CONTENT	FROM	TO	SIZE	PUT IN	PULLED OUT
				8 5/8	360'	none
				5 1/2	4538'	3500'

Describe in detail the manner in which the well was plugged, indicating where the mud fluid was placed and the method or methods used in introducing it into the hole. If cement or other plugs were used, state the character of same and depth placed, from feet to feet for each plug set.

Set 10' rock bridge from 4080' to 4070' and mix and dump 5 sacks of cement w/dump bailer

Set 10' rock bridge from 260' to 250' and dump 4 cubic yards of ready mix to surface

RECEIVED
STATE CORPORATION COMMISSION
MAY 27 1968
CONSERVATION DIVISION
Wichita, Kansas

(If additional description is necessary, use BACK of this sheet)
Name of Plugging Contractor Flint Engineering and Const. Co.
Address 2375 W. Central El Dorado, Kansas

STATE OF Kansas, COUNTY OF Butler, ss.

(employee of owner) or (owner or operator) of the above-described well, being first duly sworn on oath, says: That I have knowledge of the facts, statements, and matters herein contained and the log of the above-described well as filed and that the same are true and correct. So help me God.

(Signature) *E. C. Law*


(Address)

23 day of May, 19 68

James L. Davis

Notary Public.

Subscribed and sworn to before me this Sept. 19, 1971

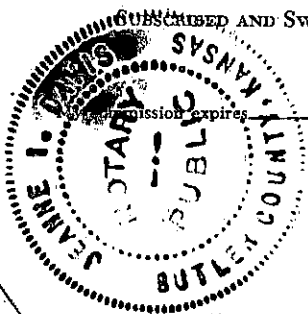

WELL LOG BUREAU—KANSAS GEOLOGICAL SOCIETY
508 East Murdock, Wichita, Kansas

COPY


Company: LARIO OIL & GAS CO.
Farm: Eubank Estate "B" No. 1

SEC. 30 T. 28 R. 14W
NE SE NW

Total Depth. 4800'
Comm. 3-22-54 Comp. 4-18-54
Shot or Treated.
Contractor: Buick Drilling, Inc.
Issued. 5-29-54

County Pratt KANSAS

RECEIVED
STATE CORPORATION COMMISSION
MAY 6 1968
CONSERVATION DIVISION
Wichita, Kansas

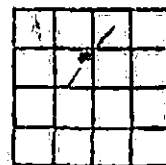

CASING:
8 5/8" 360' w/470' sx com.

Elevation: 2037 D F

Production. Dry

Figures indicate Bottom of Formations.
Schlumberger TD 4797

shale-shells	105
sand-gravel	195
sand	275
red bed	905
Anhydrite	930
shale	1035
shale-shells	1425
shale-salt	1570
shale-shells	2015
brown limo-shale	2060
limo	2280
limo-shale	2365
limo	2445
limo-shale	3270
limo	3385
limo-shale	3444
brkn limo	3485
limo	3550
limo-shale	3610
limo	3687
limo-shale	3725
limo brkn	3775
limo	3825
limo-shale	3935
limo	3997
limo-shale	4040
limo	4094
limo-shale	4101
limo	4211
limo-shale	4230
limo	4274
limo-shale	4300
limo	4364
limo-shale	4468
limo-shale-chert	4492
cherty limo-shale	4510
limo	4520
limo-shale	4535
chert-shale	4545
limo-shale	4580
shale	4600
limo-shale	4624
brkn limo	4649
limo-shale	4670
limo sdy	4692
shale-limo	4764
Arbuckle limo	4800
Total Depth	

TOP-PERF. 4095' supposed to be
squeezed off. w/ 50 cks Cement =
plug set at 4226' supposed to be down
to bottom.

old Well Workover Pipe run
on work down =

make bridge so cement will be
about 600' off Bottom in pipe.

TOPS: (Electric Log)
Topeka
Lansing-Kansas City
Conglomerate
Mississippi
Vicksburg

3257-
4046
4469
4520
4540

Pipe T.D. 4538'