


STATE OF KANSAS  
STATE CORPORATION COMMISSION  
CONSERVATION DIVISION  
P. O. BOX 17027  
WICHITA, KANSAS 67217

FORM CP-4

WELL PLUGGING RECORD

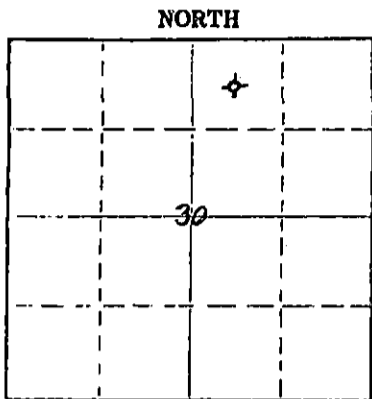

Locate well correctly on above Section Plot

Pratt County, Sec. 30 Twp. 28S Rge. (E) 14 (W)  
Location as "NE/CNW/SW" or footage from lines C NW NE  
Lease Owner Hummon Oil Company  
Lease Name Brubacker Well No. 1  
Office Address 1725 Vickers-KSB&T Bldg., Wichita, Kansas  
Character of Well (completed as Oil, Gas or Dry Hole) Dry Hole  
Date well completed October 8, 1977  
Application for plugging filed October 8, 1977  
Application for plugging approved October 8, 1977  
Plugging commenced October 8, 1977  
Plugging completed October 8, 1977  
Reason for abandonment of well or producing formation Dry Hole

If a producing well is abandoned, date of last production 19\_\_\_\_  
Was permission obtained from the Conservation Division or its agents before plugging was commenced? Yes

Name of Conservation Agent who supervised plugging of this well \_\_\_\_\_  
Producing formation \_\_\_\_\_ Depth to top \_\_\_\_\_ Bottom \_\_\_\_\_ Total Depth of Well 4592 Feet  
Show depth and thickness of all water, oil and gas formations.

OIL, GAS OR WATER RECORDS				CASING RECORD		
FORMATION	CONTENT	FROM	TO	SIZE	PUT IN	FULLED OUT
		0'	385'	8-5/8"	378.47'	None

Describe in detail the manner in which the well was plugged, indicating where the mud fluid was placed and the method or methods used in introducing it into the hole. If cement or other plugs were used, state the character of same and depth placed, from \_\_\_\_\_ feet to \_\_\_\_\_ feet for each plug set.

40 sacks Cement at 450', 30 sacks cement at 360',  
1/2 sack hulls and 12 sacks cement at 40',  
3 sacks cement in rat hole.

RECEIVED  
STATE CORPORATION COMMISSION  
OCT 20 1977  
10-20-77

(If additional description is necessary, use BACK of this sheet)  
Name of Plugging Contractor Allied Cementing Company  
Address Box 31, Russell, Kansas 67665  
CONSERVATION DIVISION  
Wichita, Kansas

STATE OF KANSAS COUNTY OF SEDGWICK ss.

John H. Knightley, agent (employee of owner) or (owner or operator) of the above-described well, being first duly sworn on oath, says: That I have knowledge of the facts, statements, and matters herein contained and the log of the above-described well as filed and that the same are true and correct. So help me God.

(Signature) *John H. Knightley*  
301 S. Broadway, Wichita, Kansas  
(Address)

SUBSCRIBED AND SWORN TO before me this 17th day of October, 1977.

My commission expires March 12, 1979  
*Stella J. Lips*  
Notary Public.

Hummon Oil Company - Brubacker #1  
C NW NE Sec. 30-28S-14W  
Pratt County, Kansas

Contractor: D. R. Lauck Oil Company, Inc.  
301 S. Broadway  
Wichita, Kansas 67202

Commenced: September 30, 1977  
Completed: October 8, 1977

Drillers Log

Shale & Sand	390
Red Bed	885
Anhydrite	902
Shale	1275
Shale & Shells	2490
Shale & Lime	2935
Shale & Shells	3120
Shale & Lime	3475
Shale & Shells	3675
Shale & Lime	3980
Shale & Shells	4100
Shale & Lime	4170
Lime	4280
Lime & Shale	4460
Lime	4592 RTD

RECEIVED  
STATE CORPORATION COMMISSION  
OCT 20 1977  
CONSERVATION DIVISION  
Wichita, Kansas