


Give All Information Completely
Make Required Affidavit
Mail or Deliver Report to:
Conservation Division
State Corporation Commission
800 Biting Building
Wichita, Kansas

WELL PLUGGING RECORD

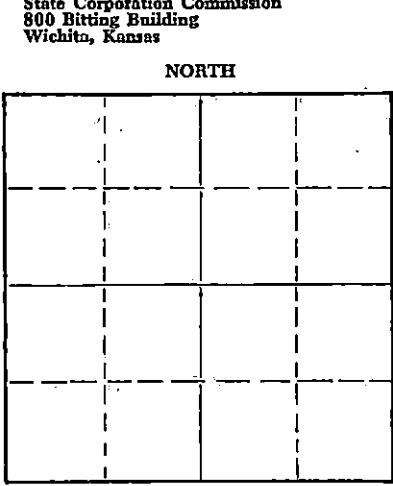

Locate well correctly on above Section Flat

Pratt County, Sec. 27 Twp. 28 Rge. 14 (E) (W)
Location as "NE/CNW/SW" or footage from lines NE NE NW
Lease Owner Musgrove Petroleum Corporation
Lease Name THOMPSON Well No. 1
Office Address 518 Petroleum Building, Wichita, Kansas.
Character of Well (completed as Oil, Gas or Dry Hole) Dry hole
Date well completed August 19, 19 54
Application for plugging filed verbally August 19, 19 54
Application for plugging approved verbally August 19, 19 54
Plugging commenced August 19, 19 54
Plugging completed August 19, 19 54
Reason for abandonment of well or producing formation Dry hole
If a producing well is abandoned, date of last production 19
Was permission obtained from the Conservation Division or its agents before plugging was commenced? verbally - yes

Name of Conservation Agent who supervised plugging of this well
Producing formation Depth to top Bottom Total Depth of Well 4681 Feet
Show depth and thickness of all water, oil and gas formations.

OIL, GAS OR WATER RECORDS

CASING RECORD

FORMATION	CONTENT	FROM	TO	SIZE	PUT IN	PULLED OUT
				8-5/8"	225'	

Describe in detail the manner in which the well was plugged, indicating where the mud fluid was placed and the method or methods used in introducing it into the hole. If cement or other plugs were used, state the character of same and depth placed, from feet to feet for each plug set.

Filled hole with mud to 300'
Set 1st plug at 300' W/20 sx cement.
Filled hole with mud to 35'
Set 2nd plug at 35' W/10 sx cement.

(If additional description is necessary, use BACK of this sheet)
Name of Plugging Contractor Musgrove Petroleum Corporation
Address 518 Petroleum Building, Wichita, Kansas.

STATE OF Kansas, COUNTY OF Sedgwick
I, Gordon L. Koelling (employee of owner) or (owner/operator) of the above-described well, being first duly sworn on oath, says: That I have knowledge of the facts, statements, and matters herein contained and the log of the above-described well as filed and that the same are true and correct. So help me God.

(Signature) *Gordon L. Koelling*
518 Petroleum Building, Wichita, Kansas.
(Address)

SUBSCRIBED AND SWORN TO before me this 23rd day of August, 19 54

My commission expires July 16, 1955.

Alma E. Lane
Notary Public.

PLUGGING
FILE SEC 27 T 28 R 14 W
BOOK PAGE 58 LINE 9

RECEIVED
STATE CORPORATION COMMISSION
AUG 25 1954
8-25-54
CONSERVATION DIVISION
Wichita, Kansas

CONTRACTOR'S WELL LOG

COMPANY: Musgrove Petroleum Corporation
 CONTRACTOR: Musgrove Petroleum Corporation
 FARM: THOMPSON #1
 LOCATION: NE NE NW
 Sec. 27-28-14, Pratt County, Ks.
 COMMENCED: July 30, 1954
 COMPLETED: August 19, 1954

0	155	Sand
155	179	River gravel & sand
179	353	Red Bed
353	1260	Red bed & shale
1260	1720	Shale & shells
1720	1750	Anhydrite
1750	2090	Shale & lime
2090	2217	Shale & lime shells
2217	2410	Lime & shale
2410	2480	Lime
2480	3890	Lime & shale
3890	4295	Lime
4295	4441	Lime & shale
4441	4452	Lime
4452	4498	Lime & shale
4498	4532	Lime
4532	4537	Sandy lime
4537	4573	Lime
4573	4681	Lime & shale
	4681	Rotary Total Depth

Set 8-5/8" surface pipe at 225' with 225 sacks of cement and 4 calcium chloride

Dry and Abandoned.

STATE OF KANSAS)
)) SS
 COUNTY OF SEDGWICK)

I, GORDON L. KOELLING, do hereby certify that the above and foregoing is a true and correct copy of the log of the THOMPSON #1 NE NE NW, Section 27-28-14, Pratt County, Kansas, as reflected by the files of the Musgrove Petroleum Corporation.

MUSGROVE PETROLEUM CORPORATION

BY *Gordon L. Koelling*
 Secretary-Treasurer

Subscribed and sworn to before me, a Notary Public, in and for Sedgwick County, Kansas, this 23rd day of August, 1954.

Alvin E. Rose
 Notary Public

My commission expires July 16, 1955.

RECEIVED
 STATE CORPORATION COMMISSION
 AUG 25 1954
 CONSERVATION DIVISION
 Wichita, Kansas

COUPLING
 FILE SEC 27-28-14W
 BOOK PAGE 28 LINE 9