

15.151-00317-60-01

STATE OF KANSAS
STATE CORPORATION COMMISSION

WELL PLUGGING RECORD

Give All Information Completely
Make Required Affidavit
Mail or Deliver Report to:
Conservation Division
State Corporation Commission
800 Bittling Building
Wichita, Kansas

Pratt County, Sec. 26 Twp. 28S Rge. 14W(E) (W)

Location as "NE/CNW/SW" or footage from lines SE SE SE

Lease Owner Orville H. Parker

Lease Name Woolfolk

Well No. 1

Office Address Box 791 - Ponca City, Oklahoma

Character of Well (completed as Oil, Gas or Dry Hole) _____

Date well completed 10-8 1955

Application for plugging filed 11-2 1955

Application for plugging approved 10-31 1955


Plugging commenced October 24 1955

Plugging completed November 1 1955

Reason for abandonment of well or producing formation Not economically productive

If a producing well is abandoned, date of last production - 19-

Was permission obtained from the Conservation Division or its agents before plugging was commenced? Yes

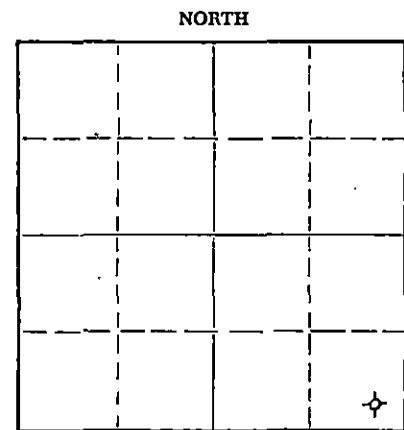

Locate well correctly on above Section Plat

Name of Conservation Agent who supervised plugging of this well Merle Rives

Producing formation Simpson-dry Depth to top _____ Bottom _____ Total Depth of Well 4598 Feet

Show depth and thickness of all water, oil and gas formations.


OIL, GAS OR WATER RECORDS

CASING RECORD

FORMATION	CONTENT	FROM	TO	SIZE	PUT IN	PULLED OUT
				8-5/8"	348'	None
				5-1/2"	4598'	2356'
				Cement inside casing filled to 4493' and casing was perforated at 4466'.		

Describe in detail the manner in which the well was plugged, indicating where the mud fluid was placed and the method or methods used in introducing it into the hole. If cement or other plugs were used, state the character of same and depth placed, from _____ feet to _____ feet for each plug set.

Filled the hole with sand from 4493' to 4450' and ran 5 sacks of cement. Pulled casing up to 1500' and then circulated hole with 20 sacks of jell mud. Mudded the hole to 300', set a 10' rock bridge and ran 20 sacks of cement. Mudded the hole to 35', set a 10' rock bridge and ran 10 sacks of cement on top. Plugging completed.

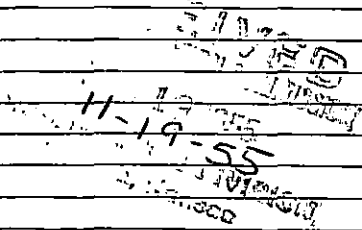

(If additional description is necessary, use BACK of this sheet)

Name of Plugging Contractor West Supply Co., Inc.

Address Chase, Kansas

STATE OF Oklahoma, COUNTY OF Key, ss. Thalia Welborn

(employee of owner) or (owner or operator) of the above-described well, being first duly sworn on oath, says: That I have knowledge of the facts, statements, and matters herein contained and the log of the above-described well as filed and that the same are true and correct. So help me God.

(Signature) Thalia Welborn

Box 791, Ponca City, Oklahoma
(Address)

SUBSCRIBED AND SWORN to before me this 16th day of November, 19 55

My commission expires November 12, 1957

Katherine Hinton
Katherine Hinton - Notary Public.

PLUGGING
REC 26728 R 14W
BOOK PAGE 12 LINE 31