


WELL PLUGGING RECORD

Give All Information Completely  
Make Required Affidavit  
Mail or Deliver Report to:  
Conservation Division  
State Corporation Commission  
800 Bittling Building  
Wichita, Kansas

NORTH

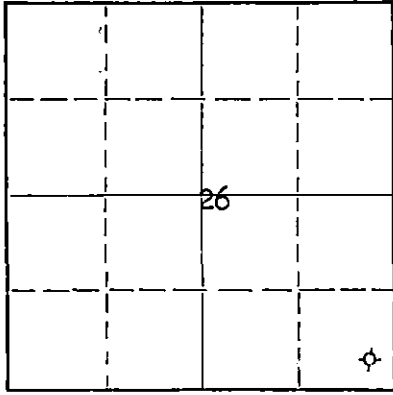

Locate well correctly on above Section Plat

Pratt County, Sec. 26 Twp. 28 S Rge. 11 (W) (W)  
Location as "NE/CNW/SW" or footage from lines C SE SE SE  
Lease Owner Coppinger Drilling, Inc et al  
Lease Name Woolfolk #1 Well No. 1  
Office Address 320 Union Natl Bk Bldg., Wichita, Ks.  
Character of Well (completed as Oil, Gas or Dry Hole) Dry hole  
Date well completed Dec. 29 1954  
Application for plugging filed Dec. 29 1954  
Application for plugging approved Dec. 29 1954  
Plugging commenced Dec. 29 1954  
Plugging completed Dec. 30 1954  
Reason for abandonment of well or producing formation dry hole

If a producing well is abandoned, date of last production 19  
Was permission obtained from the Conservation Division or its agents before plugging was commenced? yes

Name of Conservation Agent who supervised plugging of this well M. A. Rives, Pratt, Ks.  
Producing formation Depth to top Bottom Total Depth of Well 4595 Feet  
Show depth and thickness of all water, oil and gas formations.

OIL, GAS OR WATER RECORDS

CASING RECORD

FORMATION	CONTENT	FROM	TO	SIZE	PUT IN	PULLED OUT

Describe in detail the manner in which the well was plugged, indicating where the mud fluid was placed and the method or methods used in introducing it into the hole. If cement or other plugs were used, state the character of same and depth placed, from feet to feet for each plug set.

Filled hole with mud laden fluid to within 300' of top  
Cemented with 30 sax; filled hole to 35' of top;  
cemented with 10 sax.

RECEIVED  
STATE CORPORATION COMMISSION  
JAN 3 - 1955  
1-4-55  
CONSERVATION DIVISION  
Wichita, Kansas

(If additional description is necessary, use BACK of this sheet)

Name of Plugging Contractor Coppinger Drilling, Inc.  
Address 320 Union Natl Bk Bldg., Wichita, Ks.

STATE OF Kansas, COUNTY OF Sedgwick, ss.  
Lee Poulsen (employee of owner) of the above-described well, being first duly sworn on oath, says: That I have knowledge of the facts, statements, and matters herein contained and the log of the above-described well as filed and that the same are true and correct. So help me God.

(Signature) Lee Poulsen  
for Coppinger Drilling, Inc.  
320 Union Natl Bk Bldg., Wichita, Ks.  
(Address)

SUBSCRIBED AND SWORN TO before me this 3rd day of January, 1955

My commission expires March 7, 1956

Margie Brown  
Notary Public.

PLUGGING  
FILE SEC 26-28-14W  
BOOK PAGE 88 LINE 20

DRILLERS LOG

Owner-Operator: Coppinger Drilling, Inc., et al  
Contractor: Coppinger Drilling, Inc.

Woolfolk #1  
SE SE SE Sec. 26-28S-14W  
Pratt County, Kansas

Clay	85
Sand	150
Shale	195
Sand	220
Red bed	350
Plug and cement	275-350
Red bed and shale	520
Red shale and shells	575
Red shale and gypsum	640
Sand and red shale	800
Shale and shells	875
Red bed and shale	1110
Shale and shells	1425
Salt	1465
Shale	1670
Shale and shells	1750
Shale and lime	1785
Shale and shells	1900
Lime and shale	1960
Shale and shells	2185
Broken lime	2260
Lime	2350
Lime and shale	2420
Lime	2495
Lime and shale	3270
Lime	3355
Shale and lime	3455
Sandy lime	3525
Lime	3700
Lime and shale	3835
Sandy lime and shale	3935
Lime	4312
Lime and shale	4359
Lime and chert	4388
Lime, shale, chert	4420
Chert	4435
Lime and chert	4460
Chert	4483
Shale	4493
Cherty lime	4505
Lime and chert	4527
Shale	4578
Lime	4595 - R T D

Casing:  
8-5/8" set @ 232' w/200 sax posmix  
and 2 sx cal. chloride

Tops: (Sample)

Topoka	3364
Heebner	3758
Toronto	3779
Douglas Group	3802
Lansing-Kansas City	3953
Base Kansas City	4313
Marmaton	4327
Penn. Basal Cong	4392
Viola	4427
Simpson	4482
Sand #1	4493
Arbuckle	4574
Total Depth	4595

D & A

Commenced: Dec. 10, 1954  
Completed: Dec. 30, 1954

Elevation: 1977 RB  
1975 DF  
1973 GL

D & A

RECEIVED  
STATE CORPORATION COMMISSION

JAN 4 1955

CONSERVATION DIVISION  
Wichita, Kansas

State of Kansas,  
County of Sedgwick, ss.

I, the undersigned, being duly sworn on oath, state that the above statement  
and log is a true record and log of the well drilled at the location above described.

Lee Poulsen

Subscribed and sworn to before me this 3rd day of

February 1955

Wayne Broadbent  
Notary Public

My commission expires:

March 3, 1956

PLUGGING  
WELL SEC 26 T 28 R 14W  
BOOK PAGE 84 LINE 20

