


STATE OF KANSAS
STATE CORPORATION COMMISSION

WELL PLUGGING RECORD

Give All Information Completely
Make Required Affidavit
Mail or Deliver Report to
Conservation Division
State Corporation Comm.
245 North Water
Wichita, KS 67202

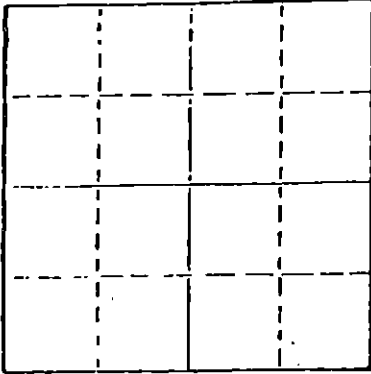

Locate well correctly on above
Section Plot

Pratt County, Sec. 27 Twp. 29S Rge. 12 E/W
Location as "NE/CNW/SW" or footage from lines
Thornton Anderson NE NE NE

Lease Owner Thornton Anderson
Lease Name Miller Well No. 1
Office Address Suite 746 300 W. Douglas Wichita, Ks. 67202
Character of Well (Completed as Oil, Gas or Dry Hole) Dry & Abandoned

Date Well completed 8-14-78 19
Application for plugging filed 8-14-78 19
Application for plugging approved 8-14-78 19
Plugging commenced 8-14-78 19
Plugging completed 8-14-78 19
Reason for abandonment of well or producing formation Dry

If a producing well is abandoned, date of last production 19

Was permission obtained from the Conservation Division or its agents before plugging was commenced? Yes

Name of Conservation Agent who supervised plugging of this well Bill Owens
Producing formation _____ Depth to top _____ Bottom _____ Total Depth of Well _____
Show depth and thickness of all water, oil and gas formations.

OIL, GAS OR WATER RECORDS

CASING RECORD

FORMATION	CONTENT	FROM	TO	SIZE	PUT IN	PULLED OUT

Describe in detail the manner in which the well was plugged, indicating where the mud fluid was placed and the method or methods used in introducing it into the hold. If cement or other plugs were used, state the character of same and depth placed, from _____ feet to _____ feet for each plug set.

Plug #1 @ 540 w/40 sks
Plug #2 @ 240 w/40 sks
Plug & Bridge @ 40 w/15 sks
Rathole 5 sks

RECEIVED
STATE CORPORATION COMMISSION
AUG 24 1978
AUG 30 1978 8-30-1978
CONSERVATION DIVISION
Wichita, Kansas

(If additional description is necessary, use BACK of this sheet)

Name of Plugging Contractor _____

STATE OF Kansas COUNTY OF Sedgwick, ss.
Jack W. Gabbert (employee of owner) or (owner or operator)
of the above-described well, being first duly sworn on oath, says: That I have knowledge of the facts, statements, and matters herein contained and the log of the above-described well as filed and that the same are true and correct. So help me God.

(Signature) [Signature]
830 Sutton Place Wichita, Ks.
(Address)

SUBSCRIBED AND SWORN TO before me this 23rd day of August, 19 78

X Elizabeth J. Edwards
Elizabeth J. Edwards Notary Public.

My commission expires February 6, 1979.



*Miller #1 to Comm
State Corp*

GABBERT-JONES, INC.
WICHITA, KANSAS
DRILLERS' WELL LOG

RECEIVED
STATE CORPORATION COMMISSION

AUG 22 1978

Miller #1
NE-NE-NE Sec 27-29S-12W
Pratt County Kansas

Commenced: 8-4-78

Completed: 8-14-78

CONSERVATION DIVISION
Wichita, Kansas

OPERATOR: THORNTON ANDERSON

From	Depth to	Formation	Remarks
0	160	Sand-Clay	Ran 7 jts of 38# 12 3/4" csg
160	345	Redbed	set @ 259' Cemented w/
345	1850	Lime-Shale	300 sks Common 2% Gel
1850	2830	Shale-Lime	3% CC - Not Returns
2830	4430	Lime-Shale	PD @ 3:30 a.m. 8-5-78
4430	4548	Lime	1" to 55' Cemented w/
4548	4600	Lime-Shale	100 sks Common 3% CC
			2nd Job Complete @ 7:15 a.m. 8-5-78
	4600 - TD		

DRY & ABANDONED

STATE OF KANSAS)
) SS
COUNTY OF SEDGWICK)

I, the undersigned, being duly sworn on oath, state that the above Drillers' Well Log is true and correct to the best of my knowledge and belief and according to the records of this office.

GABBERT-JONES, INC.

James S. Sutton II
JAMES S. SUTTON II

Subscribed and sworn to before me this 18th day of August, 1978.

Elizabeth J. Edwards
ELIZABETH J. EDWARDS-NOTARY PUBLIC

My Commission expires February 6, 1979.

