


STATE OF KANSAS  
STATE CORPORATION COMMISSION

Form CP-4

WELL PLUGGING RECORD

Give All Information Completely  
Make Required Affidavit  
Mail or Deliver Report to:  
Conservation Division  
State Corporation Commission  
211 No. Broadway  
Wichita, Kansas

NORTH

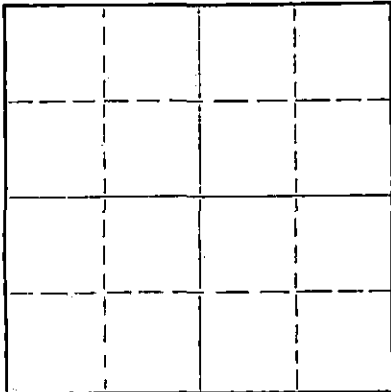

Locate well correctly on above  
Section Plat

Ford County, Sec. 10 Twp. 29S Rge. (X) 21(W)  
Location as "NE/CNW%SW%" or footage from lines C NW NW  
Lease Owner Jones-Gebert Oil, Inc.  
Lease Name Mueller Well No. 1  
Office Address 205 Central Building  
Character of Well (completed as Oil, Gas or Dry Hole) Dry Hole  
Date well completed March 9, 19 64  
Application for plugging filed March 9, 19 64  
Application for plugging approved March 9, 19 64  
Plugging commenced March 9, 19 64  
Plugging completed March 9, 19 64  
Reason for abandonment of well or producing formation Dry Hole

If a producing well is abandoned, date of last production 19  
Was permission obtained from the Conservation Division or its agents before plugging was commenced? Yes

Name of Conservation Agent who supervised plugging of this well Hugh E. Scott  
Producing formation Depth to top Bottom Total Depth of Well 5280 Feet  
Show depth and thickness of all water, oil and gas formations.

OIL, GAS OR WATER RECORDS

CASING RECORD

FORMATION	CONTENT	FROM	TO	SIZE	PUT IN	PULLED OUT
				8-5/8"	575'	

Describe in detail the manner in which the well was plugged, indicating where the mud fluid was placed and the method or methods used in introducing it into the hole. If cement or other plugs were used, state the character of same and depth placed, from feet to feet for each plug set.

Set plug at 575' with 35 sx. cement, plug at 45' with 15 sx. cement.

RECEIVED  
STATE CORPORATION COMMISSION

MAR 13 1964

CONSERVATION DIVISION  
Wichita, Kansas

3-13-64

(If additional description is necessary, use BACK of this sheet)

Name of Plugging Contractor Jones-Gebert Oil, Inc.  
Address 205 Central Building, Wichita, Kansas

STATE OF Kansas, COUNTY OF Sedgwick, ss.  
George R. Jones

(Signature of Owner or (owner or operator) of the above-described well, being first duly sworn on oath, says: That I have knowledge of the facts, statements, and matters herein contained and the log of the above-described well as filed and that the same are true and correct. So help me God.

(Signature) George R. Jones  
205 Central Building, Wichita, Kansas  
(Address)

SUBSCRIBED AND SWORN TO before me this 11th day of March, 19 64

My commission expires January 8, 1968

Lois J. McCoy  
Lois J. McCoy  
Notary Public.

DRILLER'S LOG

Company: Jones-Gebert Oil, Inc.  
 Contractor: Jones-Gebert Oil, Inc.  
 Farm: #1 Mueller, C NW NW,  
 Section 10-29S-21W  
 Ford County, Kansas

Commenced: 2/19/64  
 Completed: 3/9/64  
 Casing: 8 5/8" casing at 575' with  
 500 sx.

0	-	100	Soil & Shale
100	-	155	Sand
155	-	500	Sand Streaks & Shale
500	-	520	Sand
520	-	985	Shale & Sand
985	-	1010	Shale
1010	-	1355	Shale & Shells
1355	-	1395	Anhydrite
1395	-	2240	Shale & Shells
2240	-	2465	Shale with Lime Streaks
2465	-	2625	Lime with Shale
2625	-	2885	Lime
2885	-	2970	Lime with Shale
2970	-	3025	Shale with Lime Streaks
3025	-	3500	Lime & Shale
3500	-	3645	Sandy Lime with Shale
3645	-	3790	Lime & Shale
3790	-	3930	Lime with Shale
3930	-	4115	Lime & Shale
4115	-	4242	Lime with Shale
4242	-	4375	Lime & Shale
4375	-	4475	Lime with Shale
4475	-	4562	Lime & Shale
4562	-	4650	Lime
4650	-	4717	Lime & Shale
4717	-	4741	Lime
4741	-	4808	Lime with Shale
4808	-	5014	Lime & Shale
5014	-	5088	Lime
5088	-	5105	Lime & Shale
5105	-	5135	Conglomerate
5135	-	5280	Lime
		5280	Rotary Total Depth

**RECEIVED**  
 STATE CORPORATION COMMISSION

MAR 13 1964

CONSERVATION DIVISION  
 Wichita, Kansas


I, George R. Jones, do hereby certify that the above and foregoing is a true and correct copy of the log of the #1 Mueller, C NW NW, Section 10-29S-21W, Ford County, Kansas, as reflected by the files of Jones-Gebert Oil, Inc.

  
 GEORGE R. JONES

State of Kansas, County of Sedgwick ) ss:

Subscribed and sworn to before me, a Notary Public, in and for Sedgwick County, Kansas, this 11th day of March, 1964.

My Commission Expires:  
 January 8, 1968

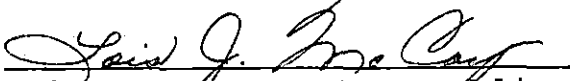  
 Lois J. McCoy, Notary Public