

STATE OF KANSAS
STATE CORPORATION COMMISSION

WELL PLUGGING RECORD

Give All Information Completely
Make Required Affidavit
Mail or Deliver Report to
Conservation Division
State Corporation Comm.
245 North Water
Wichita, KS 67202

Ford County, Sec. 6 Twp. 29S Rge. 21W 1/4/4
Location as "NE/CNW 1/4 SW 1/4" or footage from lines
C S/2 SW/4


Lease Owner Imperial Oil Company
Lease Name Bachelor Well No. 1-6
Office Address 720 Fourth Financial Center, Wichita, Ks. 67202
Character of Well (Completed as Oil, Gas or Dry Hole) _____
D & A

Date Well completed September 10, 1980
Application for plugging filed September 10, 1980
Application for plugging approved September 10, 1980
Plugging commenced September 11, 1980
Plugging completed September 11, 1980
Reason for abandonment of well or producing formation _____
D & A

If a producing well is abandoned, date of last production _____
19__

Was permission obtained from the Conservation Division or
its agents before plugging was commenced? Yes

Name of Conservation Agent who supervised plugging of this well Clarence Thomas, Jr.
Producing formation _____ Depth to top _____ Bottom _____ Total Depth of Well 5,340'
Show depth and thickness of all water, oil and gas formations.

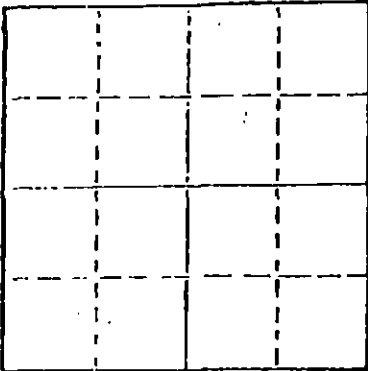

Locate well correctly on above
Section Plot

OIL, GAS OR WATER RECORDS

CASING RECORD

FORMATION	CONTENT	FROM	TO	SIZE	PUT IN	PULLED OUT
				8 5/8"	651'	-0-

Describe in detail the manner in which the well was plugged, indicating where the mud fluid
was placed and the method or methods used in introducing it into the hold. If cement or other
plugs were used, state the character of same and depth placed, from _____ feet to
_____ feet for each plug set.

Plugged hole @ 700' w/60 sx cement
@ 40' w/10 sx cement
5 sx cement in Rathole

10-2-80
RECEIVED
STATE CORPORATION COMMISSION
OCT - 2 1980
CONSERVATION DIVISION
Wichita, Kansas

(If additional description is necessary, use BACK of this sheet)

Name of Plugging Contractor Red Tiger Drilling Company
1720 KSB&T Building, Wichita, Kansas 67202


STATE OF Kansas COUNTY OF Sedgwick, ss., contractor
Gloria Fawcett (employee of ~~owner~~ ~~operator~~)
of the above-described well, being first duly sworn on oath, says: That I have knowledge of
the facts, statements, and matters herein contained and the log of the above-described well
as filed and that the same are true and correct. So help me God.

(Signature) Gloria Fawcett
1720 KSB&T Building, Wichita, Kansas 67202
(Address)

SUBSCRIBED AND SWORN TO before me this 17th day of September, 1980.

Joyce A. Hagermann
Notary Public.

My commission expires _____

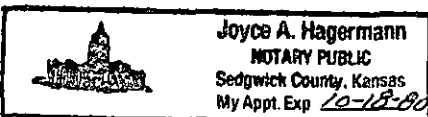

DRILLERS LOG

No. 1-6 Bachelor

CASING RECORD: 8 5/8" @ 658'
w/450 sx cement
D & A
TOTAL DEPTH: 5,340'

COMPANY: Imperial Oil Company
CONTRACTOR: Red Tiger Drilling Company
COMMENCED: August 27, 1980
COMPLETED: September 11, 1980

DESCRIPTION: C S/2 SW/4
Sec. 6-T29S-R21W
Ford County, Kansas
ELEVATION: 2,420' GR

<u>FORMATION</u>	<u>FROM</u>	<u>TO</u>	<u>REMARKS</u>
Sand	0	1770	
Shale	1770	2630	
Shale & Lime	2630	2810	
Lime	2810	3005	
Shale & Lime	3005	3570	
Lime & Shale	3570	4050	
Shale & Lime	4050	5065	
Sand	5065	5099	
Lime	5099	5340	
RTD		5340	


I certify that this is a true and correct copy of the above log to the best of my knowledge.

RED TIGER DRILLING COMPANY

Gloria Fawcett
Gloria Fawcett

Subscribed and sworn to before me this 17th day of September, 1980.

Joyce A. Hagermann
Notary Public

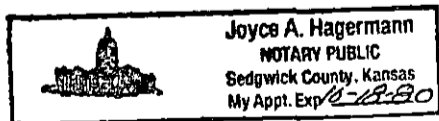

RECEIVED
STATE CORPORATION COMMISSION
OCT - 2 1980
CONSERVATION DIVISION
Wichita, Kansas