

STATE OF KANSAS  
STATE CORPORATION COMMISSION


Form CP-4

Give All Information Completely  
Make Required Affidavit  
Mail or Deliver Report to:  
Conservation Division  
State Corporation Commission  
212 No. Market  
Wichita, Kansas 67202

WELL PLUGGING RECORD

Ford County, Sec. 6 Twp. 29S Rge. 21W (E) (W)

Location as "NE/CNW/SW" or footage from lines C NE/4  
Lease Owner PICKRELL DRILLING COMPANY  
Lease Name Melencamp "A" Well No. 1  
Office Address 705 Fourth Nat'l Bank Bldg. Wichita, Ks. 67202  
Character of Well (completed as Oil, Gas or Dry Hole) Dry Hole  
Date well completed 2-20-75 19  
Application for plugging filed 2-20-75 19  
Application for plugging approved 2-20-75 19  
Plugging commenced 2-20-75 19  
Plugging completed 2-20-75 19  
Reason for abandonment of well or producing formation Dry Hole

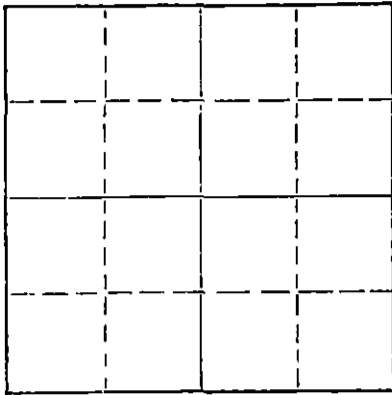

Locate well correctly on above Section Plat

If a producing well is abandoned, date of last production 19  
Was permission obtained from the Conservation Division or its agents before plugging was commenced? Yes

Name of Conservation Agent who supervised plugging of this well Edgar J. Eves  
Producing formation \_\_\_\_\_ Depth to top \_\_\_\_\_ Bottom \_\_\_\_\_ Total Depth of Well 5253 Feet  
Show depth and thickness of all water, oil and gas formations.

OIL, GAS OR WATER RECORDS

CASING RECORD

FORMATION	CONTENT	FROM	TO	SIZE	PUT IN	PULLED OUT
				8 5/8	8269d	None

Describe in detail the manner in which the well was plugged, indicating where the mud fluid was placed and the method or methods used in introducing it into the hole. If cement or other plugs were used, state the character of same and depth placed, from \_\_\_\_\_ feet to \_\_\_\_\_ feet for each plug set.

60 sacks at 650'

RECEIVED  
STATE CORPORATION COMMISSION

35 sacks at 500'

FEB 29 1975

15 sacks at 40'

CONSERVATION DIVISION  
Wichita, Kansas

Job completed 7PM 2/20/75.

2-28-75

(If additional description is necessary, use BACK of this sheet)  
Name of Plugging Contractor Pickrell Drilling Company  
Address 705 Fourth Nat'l Bank Bldg. Wichita, Ks. 67202

STATE OF Kansas COUNTY OF Sedgwick, ss.  
C. W. Sebitts (employee of owner) or (owner or operator) of the above-described well, being first duly sworn on oath, says: That I have knowledge of the facts, statements and matters herein contained and the log of the above-described well as filed and that the same are true and correct. So help me God.

(Signature) C. W. Sebitts  
705 Fourth Nat'l Bank Bldg. Wichita, Ks. 67202  
(Address)

SUBSCRIBED AND SWORN TO before me this 27 day of February, 19 75

My commission expires August 19, 1975

Helen L. Martin  
Notary Public.

ROTARY DRILLING LOG

COMPANY: PICKRELL DRILLING COMPANY  
705 4th Nat'l Bank Bldg.  
Wichita, Ks. 67202  
LOCATION: Melencamp "A" #1  
C NE/4 6-29S-21W  
Ford County, Ks.

Rotary Drilling Commenced 2-8-75  
Rotary Drilling Completed 2-20-75

CONTRACTOR: **PICKRELL DRILLING COMPANY**  
**Wichita, Kansas**

CASING RECORD: 8 5/8 surface casing set at 269' and cemented with 180 sacks cement.  
Job completed 2-8-75.

LOG

(Figures indicate bottom of formation — measurements from top of rotary bushing.)

100	Surface & Clay	4848	Lime
130	Sand	4880	Lime
155	Sand	4940	Lime
210	Shale & Sand	4987	Lime
272	Shale	5055	Lime
750	Shale-Sand-Blaine	5100	Lime
1247	Shale	5145	Lime
1385	Shale	5184	Lime
1425	Anhy	5233	Miss-Lime
1720	Shale & Shle	5253	Miss-Lime
2150	Shale & Lime		
2425	Shale & Lime		
2610	Shale & Lime		
2715	Lime & Shale		
2825	Lime & Shale		
2899	Lime & Shale		
3015	Lime		
3160	Lime		
3350	Lime & Shale		
3540	Shale & Lime		
3737	Lime & Shale		
3915	Lime & Shale		
4140	Lime & Shale		
4235	Lime & Shale		
4350	Lime & Shale		
4465	Lime		
4567	Lime		
4680	Lime		
4770	Lime		

RECEIVED  
STATE CORPORATION COMMISSION  
  
FEB 28 1975  
  
CONSERVATION DIVISION  
Wichita, Kansas

The undersigned, C. W. Sebitts, Attorney-in-Fact for PICKRELL DRILLING COMPANY, hereby certifies in behalf of said Company, that the above is a true and correct log of the formation encountered in drilling the above well as reflected by the Daily Drilling Reports.

PICKRELL DRILLING COMPANY  
By *C. W. Sebitts*  
C. W. Sebitts Attorney-in-Fact

STATE OF KANSAS }  
COUNTY OF SEDGWICK } ss.:

On this 27 day of February, 19 75, before me the undersigned, a Notary Public, in and for the County and State aforesaid, personally appeared C. W. Sebitts, to me known to be the identical person who subscribed the name of PICKRELL DRILLING COMPANY to the foregoing instrument as its Attorney-in-Fact and acknowledged to me that he executed the same as his free and voluntary act and deed, and as the free and voluntary act and deed of such company, for the uses and purposes therein set forth.

Given under my hand and seal of office the day and year last above written.

My commission expires: August 19, 1975

*Helen L. Martin*  
Helen L. Martin  
Notary Public