


STATE OF KANSAS
STATE CORPORATION COMMISSION
CONSERVATION DIVISION
P. O. BOX 17027
WICHITA, KANSAS 67217

FORM CP-4

WELL PLUGGING RECORD

Ford County, Sec. 1 Twp. 29 Rge. 21 (E) (W) X

Location as "NE/CNW&SW" or footage from lines NW SE
Lease Owner Imperial Oil Co., Inc.
Lease Name Hammer Trust Well No. #2
Office Address Box 784, Great Bend, Kansas
Character of Well (completed as Oil, Gas or Dry Hole)
Date well completed 19
Application for plugging filed 19
Application for plugging approved 19
Plugging commenced 12-29-75 19
Plugging completed 12-31-75 19
Reason for abandonment of well or producing formation

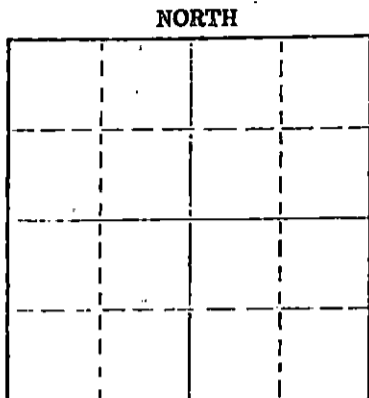

Locate well correctly on above Section Plat

If a producing well is abandoned, date of last production 19
Was permission obtained from the Conservation Division or its agents before plugging was commenced?

Name of Conservation Agent who supervised plugging of this well Clarence Thomas, Jr.
Producing formation Depth to top Bottom Total Depth of Well 5182' Feet
Show depth and thickness of all water, oil and gas formations.

OIL, GAS OR WATER RECORDS

CASING RECORD

FORMATION	CONTENT	FROM	TO	SIZE	PUT IN	PULLED OUT
				4 1/2"	5165'	3238.26'
				8 5/8"	607'	

Describe in detail the manner in which the well was plugged, indicating where the mud fluid was placed and the method or methods used in introducing it into the hole. If cement or other plugs were used, state the character of same and depth placed, from feet to feet for each plug set.

Squeezed bottom hole with 50 sacks cement.
Squeezed hole with 3 sacks hulls - 10 sacks gel, 35 sacks cement 10 sacks gel.
Released plug 50 sacks cement and 10 sacks gel. Displaced with 15 sacks cement.

(If additional description is necessary, use BACK of this sheet)
Name of Plugging Contractor Southwest Casing Pulling Co.
Address Box 364 Great Bend, Kansas 67530

STATE OF Kansas COUNTY OF Barton
Southwest Casing Pulling Co. (employee of owner) or (owner or operator) of the above-described well, being first duly sworn on oath, says: That I have knowledge of the facts, statements, and matters herein contained and the log of the above-described well as filed and that the same are true and correct. So help me God.

(Signature) W. C. Sancer, Sec.
Box 364 Great Bend, Kansas

Subscribed and Sworn to before me this 31 day of December 1975



My commission expires 24 October 1976

(Address) 75
Sidney D. Miller
Notary Public.