


15-097-20476-0000

STATE OF KANSAS
STATE CORPORATION COMMISSION

WELL PLUGGING RECORD

Give All Information Completely
Make Required Affidavit
Mail or Deliver Report to
Conservation Division
State Corporation Comm.
245 North Water
Wichita, KS 67202

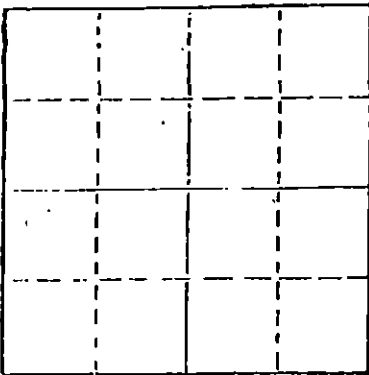

Locate well correctly on above
Section Plat

Kiowa County. Sec. 34 Twp. 29S Rge. 20W KW
Location as "NE/CNW 1/4 SW 1/4" or footage from lines _____
C-SW NW
Lease Owner K R M Petroleum Corporation
Lease Name F.L. McCormick "C" Well No. 1
Office Address Guaranty Bank Bldg., 817 17th St., Denver
Character of Well (Completed as Oil, Gas or Dry Hole) Colo. 80202
Dry Hole
Date Well completed October 1, 1978
Application for plugging filed Verbal Application 19____
Application for plugging approved Verbal Approval 19____
Plugging commenced October 1, 1978
Plugging completed October 1, 1978
Reason for abandonment of well or producing formation _____

If a producing well is abandoned, date of last production _____ 19____

Was permission obtained from the Conservation Division or its agents before plugging was commenced? Yes

Name of Conservation Agent who supervised plugging of this well Wm. T. Owen
Producing formation _____ Depth to top _____ Bottom _____ Total Depth of Well 5,212'
Show depth and thickness of all water, oil and gas formations.

OIL, GAS OR WATER RECORDS

CASING RECORD

FORMATION	CONTENT	FROM	TO	SIZE	PUT IN	PULLED OUT
				8-5/8"	557'	None

Describe in detail the manner in which the well was plugged, indicating where the mud fluid was placed and the method or methods used in introducing it into the hold. If cement or other plugs were used, state the character of same and depth placed, from _____ feet to _____ feet for each plug set.


Filled hole with heavy rotary mud from 5,212 ft. (rotary total depth) to 540 ft. Set plug at 540 ft. and cemented with 50 sacks cement. Filled hole with heavy rotary mud from 540 ft. to 40 ft. Set solid plug at 40 ft. and cemented to cellar with 12 sacks cement, 3 sacks cement in rat hole.

Plugging operations accomplished utilizing Halliburton Oil Well cementing pump truck through 4 1/2 inch drill pipe.

(If additional description is necessary, use BACK of this sheet)

Name of Plugging Contractor Halliburton Services
410 Union Center Bldg., Wichita, Kansas 67202

STATE OF Kansas COUNTY OF Sedgwick, ss.
Dean Britting, Agent of owner XXXXXXXXXXXXXXXXXXXX
of the above-described well, being first duly sworn on oath, says: That I have knowledge of the facts, statements, and matters herein contained and the log of the above-described well as filed and that the same are true and correct. So help me God.

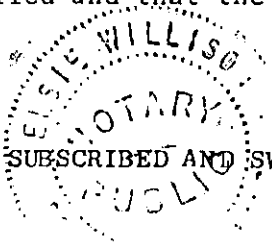

(Signature) Dean Britting
200 N. Main, Wichita, Kansas 67202
(Address)

SUBSCRIBED AND SWORN TO before me this 5th day of October, 19 78

My commission expires July 25, 1982

Elsie Willison
Elsie Willison - Notary Public.

RECEIVED
STATE CORPORATION COMMISSION

10-6-78

OCT - 6 1978

CONSERVATION DIVISION
Wichita, Kansas

KANSAS DRILLERS LOG

COMPANY K R M Petroleum

SEC. 34 T. 29S R. 20W
LOC. C-SW NW

FARM F.L. McCormick "C" No. 1

COUNTY Kiowa

ROTARY TOTAL DEPTH 5,212'

COMM. September 18, 1978 COMP. October 1, 1978

CONTRACTOR H-30, Inc.

ISSUED October 5, 1978

CASING

10 3/4"

8 5/8" Set at 557' cemented w/400 sxs cement

5 1/2"

4 1/2"

ELEVATION 2,315' K.B.

FIGURES INDICATE BOTTOM OF FORMATIONS

Red Bed	229'
Sand and Shale	449'
Red Bed and Anhydrite	480'
Shale	671'
Red Bed and Shale	980'
Shale and Red Bed	2,235'
Shale and Anhydrite	2,535'
Lime and Shale	2,780'
Shale and Lime	3,786'
Lime and Shale	5,065'
Lime	5,095'
Lime, Shale and Chert	5,150'
Lime	5,212'
Rotary Total Depth	5,212'

I hereby certify the above and foregoing to be
a true and correct log of the above described
well as shown by the drilling reports.

H-30, Inc.


 Dean Britting

State of Kansas

County of Sedgewick

} ss:

Subscribed and Sworn to before me a Notary Public
in and for said county and state this 5th day of
October, 1978.


 Elsie Willison - Notary Public

My Commission Expires:

July 25, 1982

RECEIVED
STATE CORPORATION COMMISSION

OCT - 6 1978

CONSERVATION DIVISION
Wichita, Kansas