


STATE OF KANSAS
STATE CORPORATION COMMISSION

Form CP-4

WELL PLUGGING RECORD

Give All Information Completely
Make Required Affidavit
Mail or Deliver Report to:
Conservation Division
State Corporation Commission
211 No. Broadway
Wichita, Kansas

NORTH

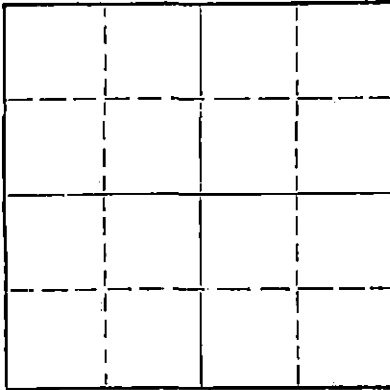

Locate well correctly on above
Section Plat

Ford County, Sec. 5 Twp. 29S Rge. 24 (W)
Location as "NE/CNW/SW" or footage from lines C SE SE
Lease Owner Carl F. Hertlein & Sterling Drilling Company
Lease Name Clark Well No. 1
Office Address Box 127, Sterling, Kansas 67579
Character of Well (completed as Oil, Gas or Dry Hole) Dry Hole
Date well completed January 1, 1966 19 66
Application for plugging filed January 1 19 66
Application for plugging approved January 1 19 66
Plugging commenced January 1 19 66
Plugging completed January 1 19 66
Reason for abandonment of well or producing formation Dry

If a producing well is abandoned, date of last production 19
Was permission obtained from the Conservation Division or its agents before plugging was commenced? Yes

Name of Conservation Agent who supervised plugging of this well Hugh Scott, Sublette, Kansas
Producing formation Depth to top Bottom Total Depth of Well 5378 Feet
Show depth and thickness of all water, oil and gas formations.

OIL, GAS OR WATER RECORDS

CASING RECORD

FORMATION	CONTENT	FROM	TO	SIZE	PUT IN	PULLED OUT
	Casing	0	112	8-5/8"	X	None

Describe in detail the manner in which the well was plugged, indicating where the mud fluid was placed and the method or methods used in introducing it into the hole. If cement or other plugs were used, state the character of same and depth placed, from feet to feet for each plug set.

Filled hole with heavy mud and 35 sacks cement on a solid bridge at 150'; 15 sacks cement on a solid bridge at 145'. Plugged by Sun Oil Well Cementing Company.

RECEIVED
STATE CORPORATION COMMISSION

1-7-66

JAN 7 1966

CONSERVATION DIVISION
Wichita, Kansas

(If additional description is necessary, use BACK of this sheet)

Name of Plugging Contractor Sterling Drilling Company
Address Box 127, Sterling, Kansas 67579

STATE OF KANSAS, COUNTY OF RICE, ss.

F. A. Wuellner (employee of owner) or (owner or operator) of the above-described well, being first duly sworn on oath, says: That I have knowledge of the facts, statements, and matters herein contained and the log of the above-described well as filed and that the same are true and correct. So help me God. STERLING DRILLING COMPANY

(Signature) F. A. Wuellner
Box 127, Sterling, Kansas
(Address)

Subscribed and Sworn to before me this 6th day of January, 1966

My Commission Expires Jan. 22, 1966
BERNARD LAUDERMILK

My commission expires

Bernard Laudermilk
Bernard Laudermilk, Notary Public.

STERLING DRILLING COMPANY
Sterling, Kansas

WELL LOG -----CLARK #1
LOCATED: SE/4 SE/4 Section 5-29S-24W, Ford County, Kansas

OWNER: Carl F. Hertlein
ROTARY DRILLING CONTRACTOR: Sterling Drilling Company

COMMENCED: December 11, 1965
COMPLETED: January 1, 1966

ROTARY TOTAL DEPTH: 5378'

LOG

0 - 226	Clay
226 - 270	Sand & Shale
270 - 437	Shale
437 - 1805	Shale & Shells
1805 - 2640	Lime & Shale
2640 - 2878	Anhydrite & Shale
2878 - 3245	Lime & Shale
3245 - 3587	Lime
3587 - 3630	Lime & Shale
3630 - 3808	Lime
3808 - 3954	Lime & Shale
3954 - 4133	Lime
4133 - 4255	Lime & Chalk
4255 - 4375	Lime
4375 - 4588	Lime & Shale
4588 - 4960	Lime
4960 - 5015	Lime & Shale
5015 - 5355	Lime
5355 - 5378	Lime & Chert T.D.

CASING RECORD

Ran 13 joints, 24# 8-5/8" casing (412.47') set at 427' K.B., cemented with 100 sacks regular and 150 sacks 40-60 Pozmix. Plug was down at 1:30 p.m.

Plugged as follows: 35 sacks on a solid bridge at 450', 15 sacks on a solid bridge at 45'. Plugged January 1, 1966, by Sun Oil Well Cementing Company.

RECEIVED
STATE CORPORATION COMMISSION

JAN 7 1966

CONSERVATION DIVISION
Wichita, Kansas