


WELL PLUGGING RECORD

Give All Information Completely.  
Make Required Affidavit.  
Mail or Deliver Report to:  
Conservation Division  
State Corporation Commission  
212 North Market, Insurance Bldg.  
Wichita, Kansas

Pratt County. Sec. 13 Twp. 28S Rge. 14 (E) W (W)  
Location as "NE/CNW/SW" or footage from lines SW NW NE  
Lease Owner D. R. Lauck Oil Company, Inc.  
Lease Name Foster Well No. 1  
Office Address 301 S. B roadway, Wichita, Kansas  
Character of Well (completed as Oil, Gas or Dry Hole) Dry Hole  
Date well completed March 17, 19 61  
Application for plugging filed March 17 19 61  
Application for plugging approved March 17 19 61  
Plugging commenced March 17 19 61  
Plugging completed March 17 19 61  
Reason for abandonment of well or producing formation dry hole

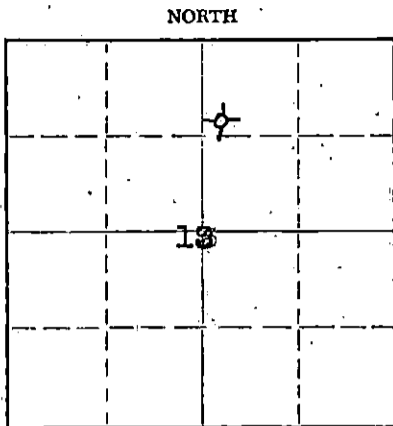

Locate well correctly on above Section Plat

If a producing well is abandoned, date of last production - 19 -  
Was permission obtained from the Conservation Division or its agents before plugging was commenced? yes

Name of Conservation Agent who supervised plugging of this well M. L. LeKamp  
Producing formation \_\_\_\_\_ Depth to top \_\_\_\_\_ Bottom \_\_\_\_\_ Total Depth of Well 4615 Feet  
Show depth and thickness of all water, oil and gas formations.

OIL, GAS OR WATER RECORDS

CASING RECORD

FORMATION	CONTENT	FROM	TO	SIZE	PUT IN	PULLED OUT
		0	303	8 5/8	303'	none

Describe in detail the manner in which the well was plugged, indicating where the mud fluid was placed and the method or methods used in introducing it into the hole. If cement or other plugs were used, state the character of same and depth placed, from \_\_\_\_\_ feet to \_\_\_\_\_ feet for each plug set.

Hole filled with mud 4615-295'  
Plug 295-291'  
Cement 291-251'  
mud 251- 35'  
plug 35- 31'  
cement 31-6' bottom of cellar

**RECEIVED**  
STATE CORPORATION COMMISSION

MAR 23 1961

CONSERVATION DIVISION  
Wichita, Kansas

3-23-61

(If additional description is necessary, use BACK of this sheet)

Name of Plugging Contractor Sun Cementing Co.  
Address Great Bend, Kansas

STATE OF Kansas, COUNTY OF Sedgwick, ss.  
John H. Knightley (employee of owner) or (OWNER REPRESENTATIVE) of the above-described well, being first duly sworn on oath, says: That I have knowledge of the facts, statements, and matters herein contained and the log of the above-described well as filed and that the same are true and correct. So help me God.

(Signature) John H. Knightley  
301 S. Broadway, Wichita, Kansas  
(Address)

SUBSCRIBED AND SWORN TO before me this 22nd day of March, 19 61

My commission expires September 14, 1962

Helene Ramey  
Notary Public.

D. R. Lauck Oil Company, Inc.

Foster No. 1

SW NW NE Sec. 13-28S-14W  
Pratt County, Kansas

Commenced: March 3, 1961  
Completed: March 17, 1961

Casing record: 303' 8 5/8" Cem. with 210 sacks 4 sacks calcium chloride

Elevation: GR 1927; DF 1929; KB 1931

Driller Log

Tops

Sand	115
red bed	770
Anhydrite	790
Blue Clay	1200
Shells & Shale	1850
Anhydrite & Shale	1925
Shale & Lime	1960
Lime & Shale	2225
Shale & Shells	2810
Shale & Lime	3035
Shale & Shells	3100
Lime & Shale	3385
Lime	3560
Lime & Shale	3680
Lime	3683
Heebner	3689
Lime & Shale	3713
Douglas	3805
Shale & Lime	3853
Lime	4250
Shale & Lime	4313
Mississippi	4332
Shale	4340
Chert & Shale	4385
Shale & Chert	4440
Shale and Lime	4464
Sand	4493
Shale	4497
Shale, Sand, Chert & Lime	4535
Shale & Lime	4555
Lime Arbuckle	4615 RTD

	<u>Sample</u>	<u>Schlumberger</u>
Anhydrite (Driller)	770 1161	
Heebner	3682-1752	
Toronto	3706-1775	
Brown Lime	3852-1922	3852-1921
Lansing	3870-1939	3870-1939
Drum	4038-2107	4036-2105
Base Kansas City	4228-2297	4226-2295
Mississippi	4313-2382	4311-2380
Kinderhook	4338-2407	4336-2405
Viola	4374-2443	4376-2445
Simpson Shale	4450-2519	4446-2515
Simpson Sand	4464-2533	4450-2519
Arbuckle	4555-2624	4553-2622
Rotary Total Depth	4615-2684	4614-2683

DST #1 (m) 4315-4332; open 1 hour; fair steady  
blow 1 hour. Recovered 30' ~~xxxx~~ mud. ISIP,  
FSIP, IFP, FFP, all 3 eco

D & A