


STATE OF KANSAS
STATE CORPORATION COMMISSION

Give All Information Completely
Make Required Affidavit
Mail or Deliver Report to:
Conservation Division
State Corporation Commission
111 No. Broadway
Wichita, Kansas

WELL PLUGGING RECORD

Pratt County, Sec. 12 Twp. 28S Rge. (E) 14 (W)

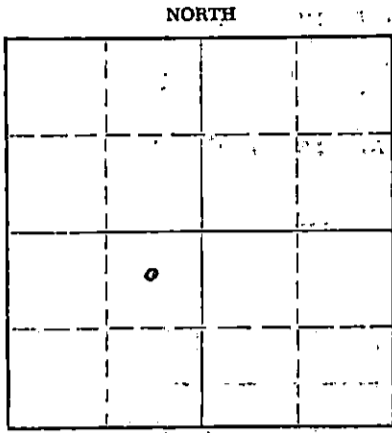

Locate well correctly on above
Section Plat

Location as "NE/CNW/SW" or footage from lines NE SW
Lease Owner Graybol Oil Corporation
Lease Name Becker Well No. 1
Office Address 2200 N. B. T. Bldg., Tulsa, Oklahoma
Character of Well (completed as Oil, Gas or Dry Hole) Dry Hole
Date well completed August 13 19 63
Application for plugging filed August 13 19 63
Application for plugging approved August 13 19 63
Plugging commenced August 13 19 63
Plugging completed August 13 19 63
Reason for abandonment of well or producing formation Dry Hole

If a producing well is abandoned, date of last production 19
Was permission obtained from the Conservation Division or its agents before plugging was commenced? Yes

Name of Conservation Agent who supervised plugging of this well Archie Elving
Producing formation _____ Depth to top _____ Bottom _____ Total Depth of Well 4610 Feet
Show depth and thickness of all water, oil and gas formations. :

OIL, GAS OR WATER RECORDS

CASING RECORD

FORMATION	CONTENT	FROM	TO	SIZE	PUT IN	PULLED OUT
Lansing Lime	Water	3882	4233	8 5/8"	348'	None
Mississippian Lime	Tight	4314	4377			
Viola Lime	Water	4377	4464			
Simpson Sand	Water	4470	4496			
Arbuckle Lime	Tight	4560	4610			

Describe in detail the manner in which the well was plugged, indicating where the mud fluid was placed and the method or methods used in introducing it into the hole. If cement or other plugs were used, state the character of same and depth placed, from _____ feet to _____ feet for each plug set.

Filled hole with heavy mud-laden fluid to 300'. Placed in one-quarter sack of hulls and 20 sacks of Portland cement. Filled hole with heavy mud-laden fluid to 40'. Placed in one-quarter sack of hulls. Cemented with ten sacks of Portland cement from 40' to ground level. Placed two sacks of Portland cement in the rat-hole.

RECEIVED
STATE CORPORATION COMMISSION

AUG 16 1963

08-16-63
CONSERVATION DIVISION
Wichita, Kansas

(If additional description is necessary, use BACK of this sheet)

Name of Plugging Contractor Graybol Oil Corporation
Address 2200 National Bank of Tulsa Building, Tulsa 3, Oklahoma

STATE OF Oklahoma, COUNTY OF Tulsa, ss.
Lyman C. Dennis (employee of owner) or (~~agent of owner~~) of the above-described well, being first duly sworn on oath, says: That I have knowledge of the facts, statements, and matters herein contained and the log of the above-described well as filed and that the same are true and correct. So help me God.

(Signature) Lyman C. Dennis

Tulsa, Oklahoma
(Address)

SUBSCRIBED AND SWORN TO before me this 14th day of August, 19 63.

Paul Carreagan
Notary Public.

My commission expires October 8, 1966



GRAYBOL OIL CORPORATION

Pratt County, Kansas

No. 1 Becker

NE SW Section 12-28S-14W

Contractor: Company Tools

Elev: 1941' D.F., 1936', G.L.

Commenced: July 28, 1963

Completed: August 13, 1963

Production: Dry & Abandoned

CASING RECORD

Set 8 5/8" casing @ 348' with 225 sacks of cement.

DEPTH	FORMATION	ELECTRA INC. ELECTRIC LOG TOPS:
0-190	Sand	Stone Corral Anhydrite 790
190-280	Red Beds	Heebner Shale 3695
280-556	Red Bed & Shale	Lansing Limestone 3882
556-1145	Shale	Base of Kansas City 4233
1145-1570	Shale & Shells	Mississippian 4314
1570-1863	Shale	Viola 4377
1863-2330	Lime	Simpson Shale 4464
2330-2598	Lime & Shale	Simpson Sand 4470
2598-2665	Lime	Arbuckle Dolomite 4560
2665-2800	Shale & Lime	
2800-2955	Lime & Shale	
2955-3095	Lime	
3095-3277	Lime & Shale	
3277-3448	Lime	
3448-3505	Lime & Shale	
3505-3614	Lime	
3614-3705	Lime & Shale	
3705-3812	Lime, Shale, & Sand	
3812-3870	Lime & Shale	
3870-4056	Lime	
4056-4112	Lime & Shale	
4112-4169	Lime	
4169-4210	Cherty Lime	
4210-4249	Lime & Shale	
4249-4255	Shale	
4255-4372	Lime & Shale	
4372-4401	Chert & Lime	
4401-4436	Lime, Shale & Chert	
4436-4445	Lime & Chert	
4445-4495	Chert, Shale & Sand	
4495-4544	Lime & Sand	
4544-4575	Shale & Lime	
4575-4610	Lime & Shale	

RECEIVED
STATE CORPORATION COMMISSION

AUG 16 1963

CONSERVATION DIVISION
Wichita, Kansas

I hereby certify that the above is a true and correct log of the above-captioned well as taken directly from the daily drilling reports.

GRAYBOL OIL CORPORATION

Lyman C. Dennis

By: Lyman C. Dennis, Geologist

STATE OF OKLAHOMA

COUNTY OF TULSA

Subscribed and sworn to this 15th day of August, 1963.

Jan Carrigan
NOTARY PUBLIC

My commission expires: October 8, 1966