


STATE OF KANSAS
STATE CORPORATION COMMISSION

Give All Information Completely
Make Required Affidavit
Mail or Deliver Report to:
Conservation Division
State Corporation Commission
212 No. Market
Wichita, Kansas

WELL PLUGGING RECORD

NORTH

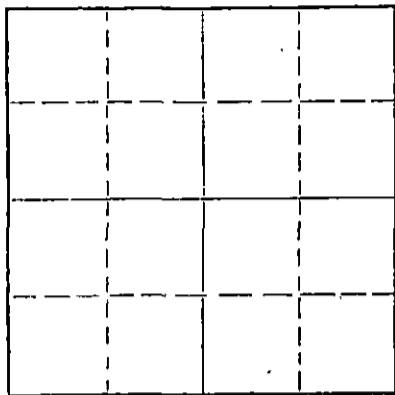

Locate well correctly on above
Section Plat

Pratt County. Sec. 25 Twp. 28S Rge. 14 (W)
Location as "NE/CNWxSWx" or footage from lines SW SW SE
Lease Owner Edmiston Oil Company
Lease Name Hertlein Well No. 1
Office Address 801 First Natl Bank Bldg., Wichita, Kansas
Character of Well (completed as Oil, Gas or Dry Hole) SW SW SE
Date well completed September 18, 1971
Application for plugging filed September 21, 1971
Application for plugging approved 19
Plugging commenced September 17, 1971
Plugging completed September 18, 1971
Reason for abandonment of well or producing formation dry hole

If a producing well is abandoned, date of last production 19
Was permission obtained from the Conservation Division or its agents before plugging was commenced? yes

Name of Conservation Agent who supervised plugging of this well Ralph J. Warren
Producing formation _____ Depth to top _____ Bottom _____ Total Depth of Well 4540 Feet
Show depth and thickness of all water, oil and gas formations.

OIL, GAS OR WATER RECORDS

CASING RECORD

FORMATION	CONTENT	FROM	TO	SIZE	PUT IN	PULLED OUT
Surface Pipe		0	406'	8-5/8"	8/26/71	none

Describe in detail the manner in which the well was plugged, indicating where the mud fluid was placed and the method or methods used in introducing it into the hole. If cement or other plugs were used, state the character of same and depth placed, from _____ feet to _____ feet for each plug set.

Set bottom plug @ 300' with 1/2 sack hulls & 35 sacks cement;
Set top plug @ 40' with 1/2 sack hulls & 10 sacks cement.


RECEIVED
STATE CORPORATION COMMISSION
SEP 22 1971
CONSERVATION DIVISION
Wichita, Kansas

(If additional description is necessary, use BACK of this sheet)
Name of Plugging Contractor E. K. Edmiston Drilling Co., Inc.
Address 801 First National Bank Bldg., Wichita, Kansas 67202

STATE OF KANSAS, COUNTY OF SEDGWICK, ss.
E. K. Edmiston (producer of owner or owner or operator) of the above-described well, being first duly sworn on oath, says: That I have knowledge of the facts, statements and matters herein contained and the log of the above-described well as filed and that the same are true and correct. So help me God

(Signature) _____
801 First National Bank Bldg., Wichita, Ks.
(Address)

SWORN AND SWORN to before me this 21st day of September, 1971

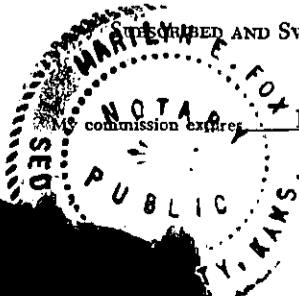

November 9, 1973

Marilyn E. Fox
Notary Public.

DRILLER'S LOG

COMPANY: Edmiston Oil Company
801 First National Bank Building
Wichita, Kansas 67202

ROTARY DRILLING COMMENCED: August 26, 1971

ROTARY DRILLING COMPLETED: September 18, 1971

WELL NAME: HERTLEIN No. 1

LOCATION: SW SW SE Section 25-28S-14W
Pratt County, Kansas

CONTRACTOR: E. K. Edmiston Drilling Co., Inc.
801 First National Bank Building
Wichita, Kansas 67202

CASING RECORD: Set 406' of 8-5/8" surface pipe
w/300 sacks cement


L O G

Measurements from top of Kelly Bushing (Elevation 1986 K.B.)

Sand and Shale	0 - 286
Red Bed and Shale	616
Shale and Shells	2025
Lime	2100
Lime with Shale Streaks	2345
Shale and Lime	2575
Shale	2730
Shale and Lime	3402
Lime with Shale Streaks	3565
Lime and Shale	3641
Lime with Shale Streaks	3761
Lime	3764
Lime and Shale	4140
Lime	4540 R.T.D.

RECEIVED
STATE CORPORATION COMMISSION
SEP 22 1971
CONSERVATION DIVISION
Wichita, Kansas

The undersigned, E. K. Edmiston, President of E. K. Edmiston Drilling Co., Inc., hereby certifies on behalf of said company, that the above log is a true and correct log of the formations encountered in drilling the above well, as reflected by the daily drilling reports.



E. K. Edmiston


STATE OF KANSAS)
) SS:
COUNTY OF SEDGWICK)

BE IT REMEMBERED that on this 21st day of September, 1971, before me, the undersigned, a Notary Public within and for the County and State aforesaid, came E. K. Edmiston, known to me to be the same person who executed the foregoing instrument on behalf of E. K. Edmiston Drilling Co., Inc., and he duly acknowledged the execution of the same for himself and for said company.

IN WITNESS WHEREOF, I have hereunto set my hand and official seal on the day and year last above written.

Commission Expires:
November 9, 1973

SEDGWICK COUNTY, KANSAS

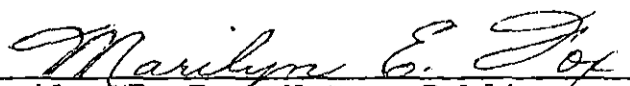

Marilyn E. Fox, Notary Public